


DX 78-1

Stafford KANSAS

Section 9 Township 21 Range 12W

Well No. 2 Bolhenn

Company Duke & Wood

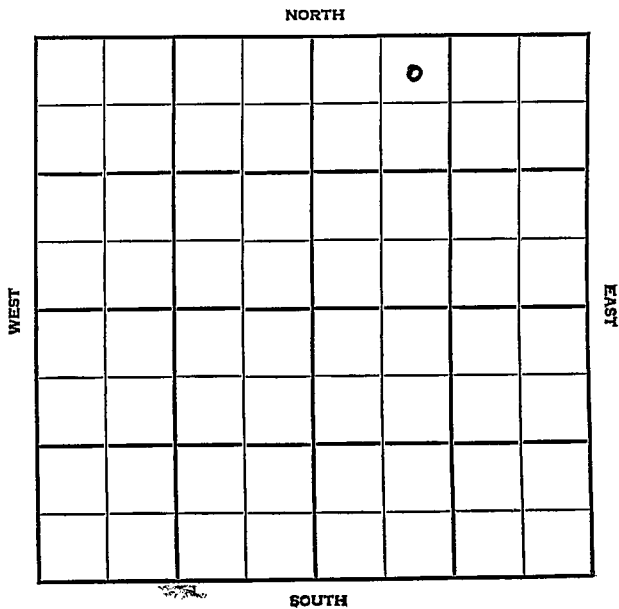

SEC.	TWP.	R.
9	21	12W

WELL NO. #2 Bolhenn FARM

COMPANY Duke & Wood

CONTRACTOR Duke & Wood


Byron Pool

330 Ft. from N. Line

Ft. from S. Line

Ft. from E. Line

990 Ft. from W. Line

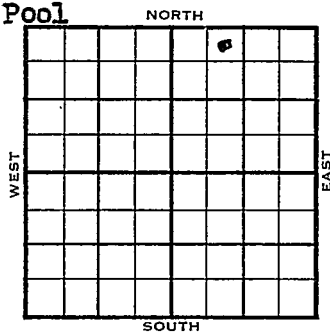

NE NW NE

1954	ELEVATION	REPORT
	1839'	

9/1 Spud 8-28-54  
8" @ 245'

9/8 Drlg. 1550'  
Spud 8-28-54  
D & A  
TD 3465'  
8" @ 245'  
Heeb. 3054', Lans 3200',  
DST 3318'-31' opn 1/2 hr, rec 10' Mud,  
O# Arb 3457'  
DST 3458'-62' opn 1 hr, rec 30' muddy  
oil, 880#  
DST 3461'-65' opn 1 hr, rec 50' gas,  
160' muddy oil, 30' wtr. 170#  
TD 3465'  
D & A

ABANDONED



