

Section 9 Township 21 Range 12 W

Well No. # 2 Krueger

Company Duke & Wood

NORTH

		0					

SOUTH

Sec. 9 Twp. 21 R. 12W

Well No. #2 Krueger Farm

Duke & Wood Company

Contractor


330 Ft. from N. Line

Ft. from S. Line

990 Ft. from E. Line

Ft. from W. Line

NW NE NW

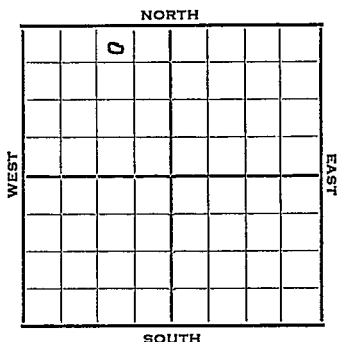

1952 Elev. 1842' REPORT

6/25 8" @ 220'
Anhy 612'
Drlg. 2010'

7/2 Heeb 3059' Br. li. 3189' Lans. 3205'
DST 3266-3342' 1 hr, 120' SW, 130' gas
Drlg. 3344'

7/9 D&A TD 3478 8" @ 220
Anhy 612 Heeb. 3059 Br Lime 3189
Lans. 3205
DST 3266-3342 opn 1 hr. Rec. 120' sw
130' gas
DST 3478 failed Arb. 3473 TD 3478
D&A **ABANDONED**

County **Stafford** State **Kansas**

Sec. **9** (Blk. Twp.) **21** (Sur. Rge.) **12W** Map No.

Operator **Duke & Wood**

Well No. **2** Farm **Krueger**

Elev. **1842** Location **NW NE NW**

	0				

FIRST REPORT

330 Ft. From **E** Line **NW**

990 Ft. From **E** Line Quarter

1st. Report **JUN 25 1952**

Completion

Remarks

Duke & Wood - Contr.

Spudding Date

Drlg. Data

8" @ 220 Anhy 612 Drlg. 2010

J. G. McGEHEE

