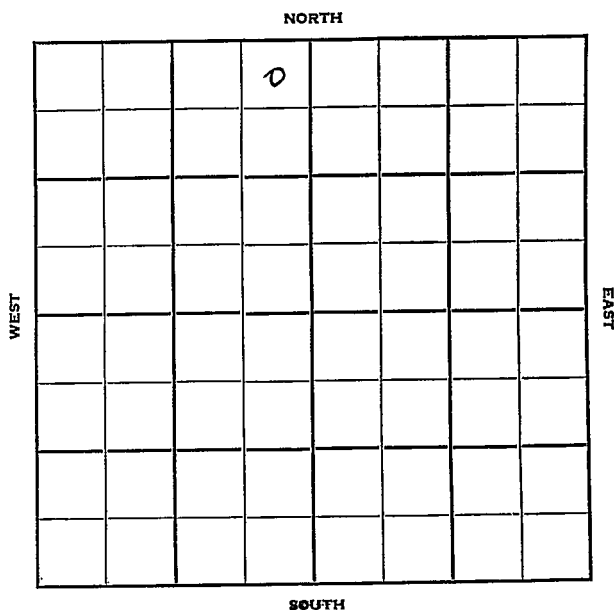


Section 9 Township 21 Range 12WWell No. #1 KruegerCompany Duke & Wood

Stafford
21

KANSAS

Sec. 9 Twp. 21 R. 12W

Well No. #1 Krueger Farm

Duke & Wood Company

Contractor


330' Ft. from N. Line

 Ft. from S. Line

330' Ft. from E. Line

 Ft. from W. Line

NE NE NW

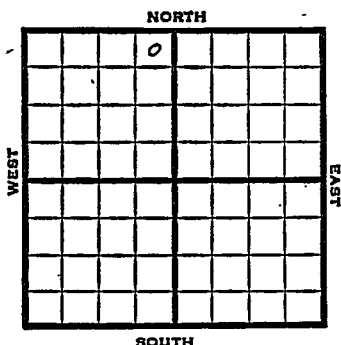

1951 Elev. 1842' REPORT

3/14 Spud 3-7-51
8" set
Anhy 620
Drlg. 1830'

4/18 Spud 3-7-51
Oil Well TD 3490
Anhy 620 Heeb. 3055'
Lans. 3199
DST 3324-88 opn 20 min
Arb. 3460 TD 3490
5" @ 3490
24/3460-64 FU 2600' oil 12 hr
S/7½ boph 500 A FU 2390' oil
12 hr
S/7½ boph Comp. 174 bopd

COMPLETES



Operator **Duke & Wood**

Well No. **1** Farm **Krueger**

Elev.	Location	NE	NE	NW
o

FIRST REPORT

330 Ft. From N Line NW

330 Ft. From E Line Quarter

1st. Report **MAR 14 1951**

Completion

Remarks

Spudding Date **3-7-51**

Drlg. Data

8" set Anhy 620 drlg. 1830

J. E. TYRA

County Stafford State Kansas
 Sec. 9 (Blk.) 21 (Sur.) 12W Map No.
 Operator Duke & Wood
 Well No. 1 Farm Krueger
 Elev. 1842 Location NE NE NW

			0			

330 Ft. From N Line NW
330 Ft. From E Line Quarter

1st. Report

Completion APR 18 1951

Remarks

Spudding Date 3-7-51

Drig. Data Oil well TD 3490

Arhy 620 Heeb. 3055 Br. lime 3184

Lans. 3199 DST 3324-88 open 20 min.

Arb. 3460 TD 3490 5" @ 3490

24/ 3460-64 FU 2600' oil 12 hr.

S/ 7½ boph 500 A FU 2390' oil 12 hr.

S/ 7½ boph Comp. 174 bopd

J. E. TYRA