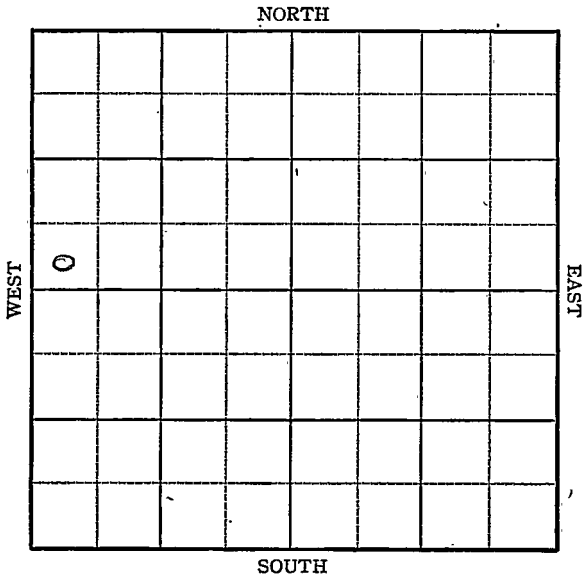


Section 9 Township 21 Range 12WWell No. 1 A. KruegerCompany Keyes Drlg.

KANSAS

Stafford

Sec. 9 Twp. 21 R. 12-W

Well No. #1 A. Krueger Farm


Keyes Drlg. Company

 Ft. from N. Line

330 Ft. from S. Line

 Ft. from E. Line

330 Ft. from W. Line

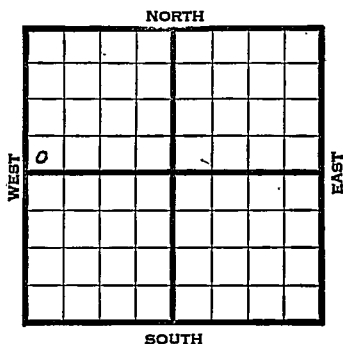

SW NW

1945

R E P O R T

7/18

Elev. 1845

8" @ 350'

Drlg. 3090'

7/23

Lans 3223

Conc 3457

Viola 3462

Simp 3516

Arb. 3545

TD 3600'

ABANDONED


KANSAS

Kansas

Pool Name WildcatMap No. 46 Sec. 9 Twp. 21 R. 12WWell No. 1 A. KruegerKeyes Drlg. Company**FIRST REPORT**

Contractor

SW NW

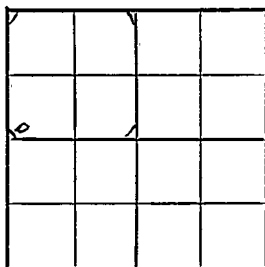SECTION PLAT Ft. from N. Line330 Ft. from S. Line Ft. from E. Line330 Ft. from W. LineStafford CountyLocationRig upDrilling and Remarks:8"-3503090**RECORD**Cased in., ft.Sand Gas Oil Total Depth **PRODUCTION**1st 24 hrs. Nat. 1st 24 hrs. after shot Gas Cu. Ft.Dry Hole Abandoned

Date


JUL 1 8 194519S. J. LEWISScout

KANSAS

Kansa Pool Name WildcatMap No. 46 Sec. 9 Twp. 21 R. 12WWell No. 1 A. KruegerKeyes Drlg. Company**ABANDONED**

Contractor

SW NW

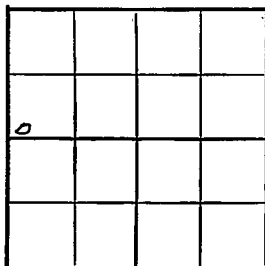E 1. 1845
SECTION PLAT Ft. from N. Line330 Ft. from S. Line Ft. from E. Line330 Ft. from W. LineStafford County**RECORD**Location Cased in., ft.Rig up Sand

Drilling and Remarks:

Gas Oil Total Depth 3400**PRODUCTION**1st 24 hrs. Nat. 1st 24 hrs. after shot Gas Cu. Ft.Dry Hole Abandoned

Date

JUL 25 1945 19S. J. LEWIS

Scout

Lane 3223
Cong 3457
Vista 3462
Sim 3516
Cr 3545