


Section 1 Township 22 Range 13W

Well No. 5 Weiszbrod

Company Anschutz Drlg.

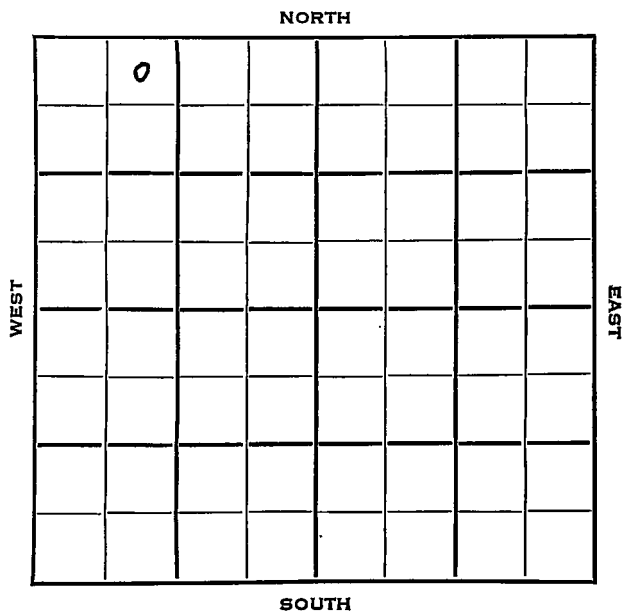

Stafford KANSAS


SEC. 1 TWP. 22 R. 13W ✓

WELL NO. 5 Weiszbrod FARM

COMPANY Anschutz Drlg.

CONTRACTOR Anschutz

330 Ft. from N. Line
 Ft. from S. Line
 Ft. from E. Line
 990 Ft. from W. Line

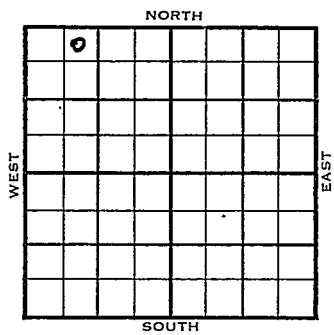

NE NW NW

	ELEVATION	REPORT
1954	1878'	
1/6	spud 1-3-54 8" @ 278 Drlg. 283'	
1/13	Heeb 3169', Lans 3316' DST 3350'-3405' 21 mins, gas in 4", F oil in 19" 1080# Drlg.	
1/20	B KC 3545' Cong. 3566' V 3571' Simp. 3604' Arb. 3656' RTD 3658 5" @ 3657 DD 3668 1/2 BOPH 3 hrs. DD 3682	
1/27	FU 1000' oil 3 1/4 hrs, DD 3683' TD S/ 2 1/2 boph 6 hrs. 600 A S/ 5 boph elec. to 3 boph 500 A	
2/3	18/ 3680-83 500 A S/ 6 boph 10 hrs.	
2/24	NR	
3/3	Spud 1-3-54 Oil Well TD 3683' 8" @ 278' Heeb 3169', Lans 3316', DST 3350'-3465' opn 21 min, gas in 4 min F/ oil in 19 min 1080# B KC 3545'	

OVER

1954

Information brought forward.

3/3

Cong 3566', Viola 3571', Simp 3604'

Arb 3656'

TD3658'

5" @ 3657'

DD 3668'

$\frac{1}{2}$ boph 3 hr.

DD 3682'

FU 1000' oil $3\frac{1}{4}$ hr. DD3683'

S/ $2\frac{1}{2}$ boph 6 hr.

500 A S/ 5 boph dec. to 3 boph 500 A

18/ 3680-83 500 A S/ 6 boph

10 hr.

Comp 77 bopd 9% Wtr.

COMPLETED

County Stafford State Kansas

Sec. 1 (Bik. Twp.) 22 (Sur. Rge.) 13W Map No. _____

Operator Anschutz Drlg.

Well No. 5 Farm Weiszbrod

Elev. _____ Location NE NE1 NW

0					

330 Ft. From N Line NW

990 Ft. From W Line Quarter

Ist. Report JAN 6 1954

Completion _____

Remarks _____

Anschutz - Contr.

Spudding Date 1-3-54

Drlg. Data _____

8" @ 278 drlg. 283.

