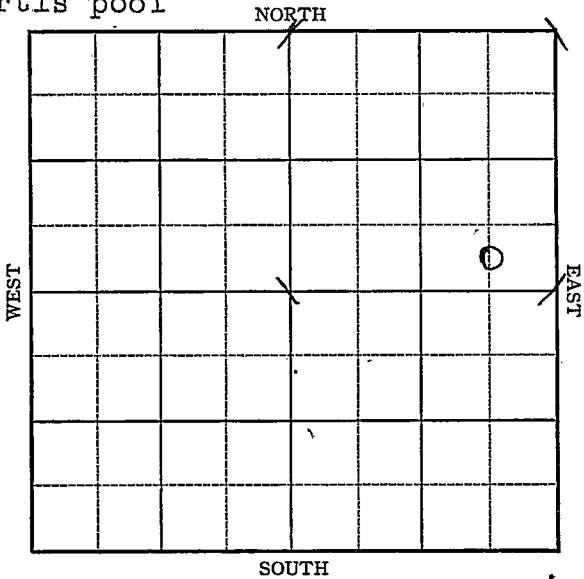


Section 1 Township 22 Range 14-W

Well No. #1 Bordewisk

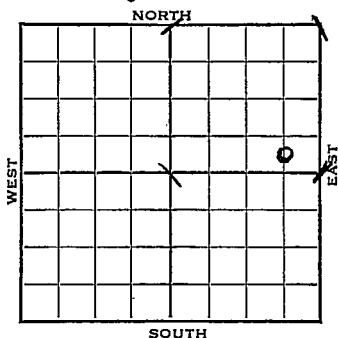
Company Phillips

Curtis pool



Sec. 1 Twp. 22 R. 14Well No. #1 Bordewick FarmPhillips Company

Curtis pool

 Ft. from N. Line330 Ft. from S. Line660 Ft. from E. Line Ft. from W. Line

C SL SE NE Elev. 1921 DF 1917 G.V.

1942

REPORT

11/10

Cellar

11/18

Rotary

11/24

8" @ 425 WOC

12/2

Anhy 750'

FT. Riley 1895

Drlg. 3220

12/9

Lans 3390

Cong. 3655

Viola 3684

Drlg. 3741 SSO

12/16

Arb. 3804

T.D. 3831'

No shows

ABANDONED

1954

1/20

O.W.W.O.
KC 3390', Cong 3655', Viola
3684', Simp 3756', Arb. 3804'
OTD 3831'
CO for SWD

OVER

244A

O.W.W/A

1954
2/3

SWD Well
TD 4421' u
KC 3390', ong 3655', Viola 3684',
Simp. 3756', Arb. 3804'
OTD 3831'
Reagan 4369', Gr Wash 4384', Gr.
4408'
TD 4421'
5" @ 3920'
CO to 4421'
Comp. for SWD Well

ABANDONED

KANSAS Stafford

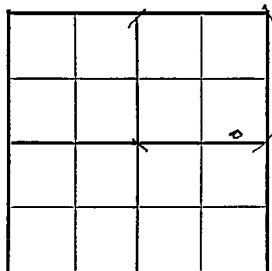
Map No. 82 Sec. 1 Twp. 22 R. 14WWell No. 1 BordewickPhillip s Company

FIRST REPORT

Contractor

C S L S E N E

SECTION PLAT

 Ft. from N. Line330 Ft. from S. Line660 Ft. from E. Line Ft. from W. Line

CURTIS POOL

Location Rig up

Drilling and Remarks:

Cellar

RECORD

Cased in., ft.Sand Gas Oil Total Depth

PRODUCTION

1st 24 hrs. Nat. 1st 24 hrs. after shot Gas Cu. Ft.Dry Hole Abandoned

Date

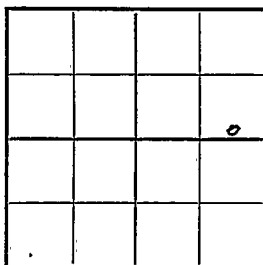
NOV 11 1942S. J. LEWIS

Scout

Map No. 82 Sec. 1 Twp. 22 R. 14WWell No. 1 BordewickPhillips CompanyABANDONED Contractor

C SL SE NE

SECTION PLAT

 Ft. from N. Line330 Ft. from S. Line660 Ft. from E. Line Ft. from W. Line

CURTIS POOL

Location Rig up

Drilling and Remarks:

Cr 83504
Nos hows

RECORD

Cased in., ft.Sand Gas Oil Total Depth 3831

PRODUCTION

1st 24 hrs. Nat. 1st 24 hrs. after shot Gas Cu. Ft.Dry Hole Abandoned

Date

DEC 16 1942 19S. J. LEWIS Scout

O.W.W.O.

County **Stafford** State **Kansas**

Sec. **1** (Blk. **22** (Sur. **14W** Map No.

Operator Phillips Pet.

Well No. **1** Farm **Bordewick**

Elev.	Location	C S L SE NE

FIRST REPORT

330 Ft. From S Line NE

660 Ft. From E Line Quarter

JAN 20 1954

1st. Report JAN 20 1954

Completion

Remarks (CWFO)

C. W. W. O.

Spudding Date , *-

Drig. Data Gurtis Pool

KC 3390 Cong. 3655 Viola 3684

Simp. 3756 Arb. 3804 OTD 3831

GO for STD

J. G. McGEHEE

J. G. McGEHEE