


Section 1 Township 22 Range 11W

Well No. #1 Bordewick

Company Republic Natural Gas

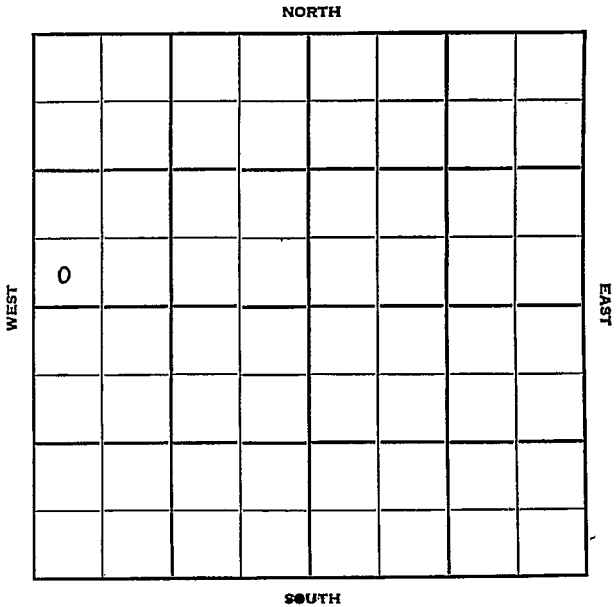

Sec. 1 Twp. 22 R. 14 W

Well No. # 1 Bordenwick Farm

Republic Natural Gas Company

Gabbert-Jones Contractor

Smallwood Pool


Ft. from N. Line

330 Ft. from S. Line

Ft. from E. Line

330 Ft. from W. Line

SW SW NW

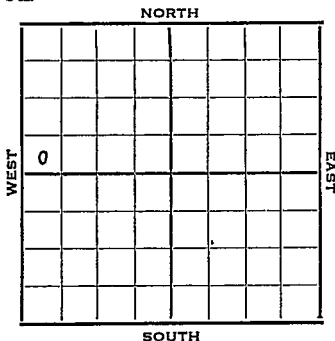

1951 Elev. 1930' REPORT

11/28 Spud 11-22-51
10" @ 246'
Drilling 1200'

1952
2/6 TD 3771 PB 3500 POP

2/13 Spud 11-22-51
Oil Well TD 3771
10" @ 246' Heeb. 3284 KC 3418
DST 3473-96 opn 45 min, Rec. 120'
o&gcm 180' muddy oil 60' oil
DST 3537-49 opn 1 hr. Rec. 5' mud
DST 3569-82 opn 1 hr. Re. 420' froggy
oil 360' oil 60' ocm
DST 3592-3604 opn 1 hr.
Rec. 150' ocm Cong. 3657 Viola 3697
DST 3698-3717 opn 45 min. Rec. 15' mud
Simp 3721 Arb. 3762
DST 3763-70 opn 1 hr Rec. 70' hocom
TD 3771 5" @ 3769 S/5 boph PB 3500
54/3473-91 S/25 boph Comp. 190 bopd

COMPLETED



Sec. 1 (Blk. Twp.) 22 (Sur. Rge.) 14W Map No.

Operator Republic Natural Gas

Well No. 1 Farm Bordewick

Elev. Location SW SW NW

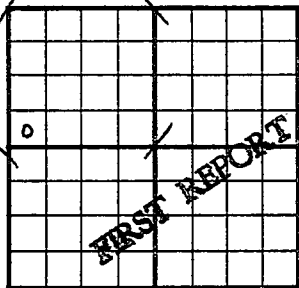

330 Ft. From S Line NW

330 Ft. From W Line Quarter

Ist. Report NOV 28 1951

Completion _____

Remarks _____

Gabbert-Jones - Contr.


Spudding Date 11-22-51

Drlg. Data Smallwood Pool

10" @ 246 drlg. 1200

J. E. TYRA

County Stafford State Kansas
 Sec. 1 (Blk. 22) (Sur. 1 4W) (Twp. 22) (Rge. 1 4W) Map No.
 Operator Republic Natural Gas
 Well No. 1 Farm Bordewick
 Elev. 1930 Location SW SW NW

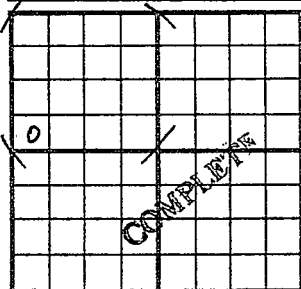

330 Ft. From S Line NW
330 Ft. From W Line Quarter

Ist. Report

Completion FEB 13 1952

Remarks Smallwood Pool

Gabbert-Jones - Contr.

Spudding Date 11-22-51

Drlg. Data Oil well TD 3771

10" @ 246 Heeb. 3284 KC 3418

DST 3473-96 open 45 min. Rec. 120' o & gm

180' muddy oil 60' oil DST 3537-49

open 1 hr. Rec. 5' mud DST 3569-82

open 1 hr. Rec. 420' froggy oil 360' oil

60' ocm DST 3592-3604 open 1 hr.

Rec. 150' ocm Cong. 3657 Viola 3697

DST 3698-3717 open 45 min. Rec. 15' mud

Simp. 3721 Arb. 3762 DST 3763-70

open 1 hr. Rec. 70' hocom TD 3771 5" @

3769 S/ 5 boph PB 3500 54/ 3473-91

S/ 25 boph Comp. 190 bopd

J. G. MCGEELE