

Section 1 Township 22 Range 14^W

Well No. #2 Bordewick

Company Republic National

NORTH

	Q						
	0						

WEST

EAST

SOUTH

Sec. 1 Twp. 22 R. 14 W

Well No. # 2 Bordewick Farm

Republic National Company

Gabbert & Jones Contractor
Small Wood


 Ft. from N. Line

990 Ft. from S. Line

 Ft. from E. Line

990 Ft. from W. Line

NE SW NW

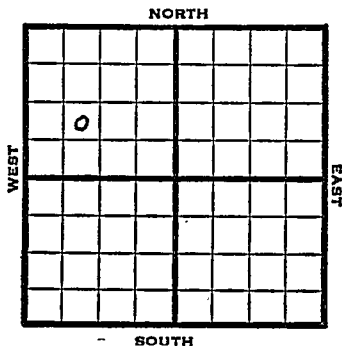

1952

Elev. 1932' REPORT

1/9

Spud 1-3-52
8" @ 276'

Drlg. 1660'

1/23

Spud 1-3-52

D&A TD 3796'

8" @ 276' Heeb. 3294 Br Li 3413

Lans. 3426

DST 3480-82 open 1 hr. rec. 390' SW

DST 3560-75 open 1/2 hr. rec. 30' mud

DST 3581-92 open 1 hr. rec. 80' mud

DST 3624-41 open 1 hr. rec. 12' mud

Arb. 3780 DST 3780-86 open 1 hr.

rec. 25' mud DST 3785-96 open 1 hr.

Rec. 90' SW TD 3796'

D&A

ABANDONED

