


Section 1 Township 22 Range 11W
Well No. 3 Bardswick
Company Republic Natural Gas

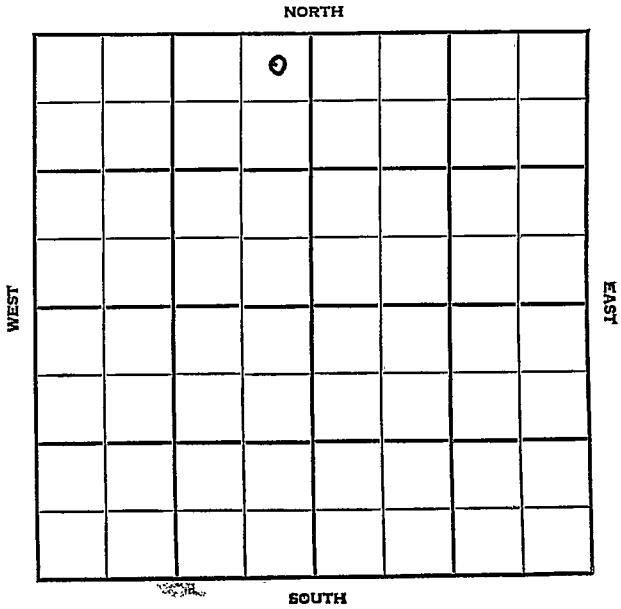

Stafford

KANSAS

SEC.	TWP.	R.
1	22	14W

WELL NO.

#3 Bardewick

FARM

COMPANY

Republic Natural Gas

CONTRACTOR

Gabbert-Jones

Smallwood Pool

NORTH

330

Ft. from N. Line

Ft. from S. Line

330

Ft. from E. Line

Ft. from W. Line

WEST

EAST

			0				

SOUTH

NE NE NW

- / -

	ELEVATION	REPORT
1954	1922'	
9/8	M I R	
9/22	Spud 9-8-54	
	D & A	
	TD 3820'	
	10-3/4" @ 310'	
	Br. Lime 3406', Lans 3416'	
	DST 3420'-68' opn 1 hr, rec 110' sl gass	
	y mud, 1215#	
	DST 3472'-97' opn 45 min, rec 110' wtry	
	mud, 900#	
	DST 3560'-91' opn 1 hr, rec 30' Mud	
	780# Viola 3630'	
	DST 3594'-3630' opn 1 hr, rec 135' mud	
	1050# Simp 3764' Arb 3804'	
	TD 3820'	
	D & A	
		ABANDONED

County **Stafford** State **Kansas**Sec. **1** (Blk.) **22** (Sur.) **14W** Map No.Operator **Republic Natural Gas**Well No. **3** Farm **Bardewick**Elev. Location **NE NE NW**

FIRST REPORT

330 Ft. From **N** Line **NW****330** Ft. From **E** Line **Quarter**1st. Report **SEP 8 1954**

Completion


Remarks

Gabbert-Jones - Contr.

Spudding Date

Drlg. Data **Smallwood Pool****M I R**

FABEN GILSTRAP

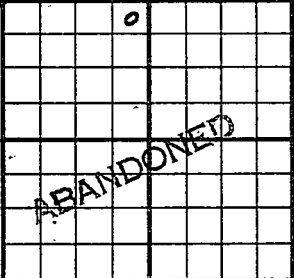County	Stafford		State	Kansas	
Sec.	1	(Blk.) Twp.	22	(Sur.) Rge.	14W Map No.
Operator	Republic Natural Gas				
Well No.	3	Farm	Bardewick		
Elev.	1922	Location	NE NE NW		
			330	Ft. From N	Line NW
			330	Ft. From E	Line Quarter
			1st. Report Sep 8 1954		
			Completion SEP 22 1954		
			Remarks		
Gabbert-Jones - Contr.					
Spudding Date 9-8-54					

Drlg. Data D & A TD 3820 Smallwood Pool
 10 3/4" @ 310 Br. lime 3406
 Lans. 3416 DST 3420-68 open 1 hr.
 Rec. 110' sl. gassy mud 1215#
 DST 3472-97 open 45 min. Rec. 110' wtry
 mud 900# DST 3560-91 open 1 hr.
 Rec. 30' mud 780# Viola 3630
 DST 3594-3630 open 1 hr. Rec. 135' mud
 1050# Simp. 3764 Arb. 3804 TD 3820
 D & A

FABEN GILSTRAP