

Section 1 Township 22 Range 11W

Well No. #5 Bordewick

Company Phillips Pet.

NORTH

					0		

WEST

EAST

SOUTH


Sec. 1 Twp. 22 R. 11WWell No. #5 Bordewick FarmPhillips Pet. CompanyBerwick ContractorCurtis Pool330 Ft. from N. Line

Ft. from S. Line

Ft. from E. Line

990 Ft. from W. Line

NE NW NE

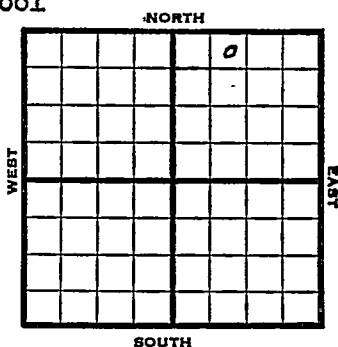

1953 Elev. 1919' REPORT

7/22 Spud 7-18-53

10" @ 396'

Anhy 795'

Drlg 1765'

7/29 Heeb 3263' Tor 3280 Br li 3384

Lans 3398

DST 3422-33, 40 mins, 30' SWCM

DST 3515-32, 1 hr, 90' wtr. 1057#

Drlg.

8/5 B KC 3623' V 3644' Simp 3683'

Arb. 3731 RTD 3744 7" @ 3732

8/12 CO 3734

B/19 BO 3 hrs.

CO 3740, S/17½ BO 4 hrs.

DD 3749 TD

S19-1/3 BO 4 hrs.

S/4½ BOPH 3 hrs., POP

8/19 NR

8/26 Spud 7-18-53

Oil Well

TD 3744

10" @ 396

Anhy 795, Heeb 3263, Tor 3280, Br

lime 3384, Lans 3398,

DST 3422-33, opn 40", rec. 30' swcm,

DST 3515-32, opn 1 hr., rec. 90' wtr

1057#

B KC 3623, Viola 3644, Simp 3683,

Arb. 3731

OVER

(Information Brought Forward)

1953
8/26

TD 3744
7ⁿ @ 3732, CO to 3734
B/19 bo 3 hrs., CO 3740
S/17 $\frac{1}{2}$ bo 4 hrs. DD 3749
S/19-1/3 bo 4 hrs.
S/4 $\frac{1}{2}$ boph
Comp. 96 bopd

COMPLETED

County Stafford State KansasSec. 1 (Blk.) 22 (Sur.) 14W Map No.Operator Phillips Pet.Well No. 5 Farm BordewickElev. Location NE NW NE

330 Ft. From N Line NE990 Ft. From W Line Quarter1st. Report JUL 22 1953

Completion

Remarks

Berwick - Contr.Spudding Date 7-18-53Drlg. Data Curtis Pool10" @ 396 Anhy 795 drlg. 1765

County Stafford State Kansas
 Sec. 1 (Blk.) 22 (Sur.) 14W Map No.
 Operator Phillips Pet.
 Well No. 5 Farm Bordewick
 Elev. 1919 Location NE NW NE

330 Ft. From N Line NE

990 Ft. From W Line Quarter

1st. Report

Completion AUG 26 1953

Remarks Curtis Pool

Berwick - Contr.

Spudding Date 7-18-53

Drilg. Data Oil well TD 3744

10" @ 396 Anhy 795 Heeb. 3263

Tor. 3280 Br. lime 3384 Lans. 3398

DST 3422-33 open 40 min. Rec. 30' swcm

DST 3515-32 open 1 hr. Rec. 90' wtr.

1057# B KC 3623 Viola 3644 Simp. 3683

Arb. 3731 TD 3744 7" @ 3732 CO to 3734

B/ 19 bo 3 hr. CO 3740 S/ 17½ bo 4 hr.

DD 3749 S/ 19 1/3 bo 4 hr. S/ 4½ boph

Comp. 96 bopd

J. G. McGEHEE