
FORM 51 Stafford KANSAS

Section 1 Township 22 Range 14W

Well No. #6 Bordewick

Company Phillips Petr.

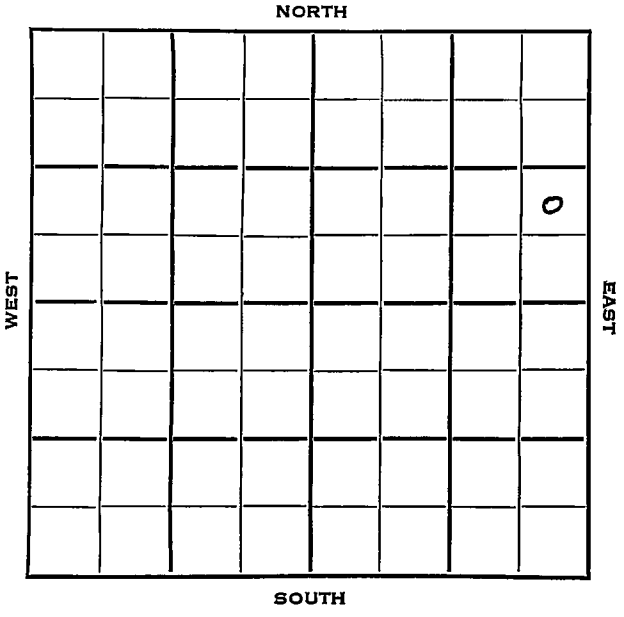

FORM 252-B

Stafford KANSAS

Sec. 1 Twp. 22 R. 14 W

Well No. # 6 Bordewick Farm

Phillips Pet. Company

Phillips Contractor

Curtis Pool


1650 Ft. from N. Line

Ft. from S. Line

330 Ft. from E. Line

Ft. from W. Line

NE SE NE

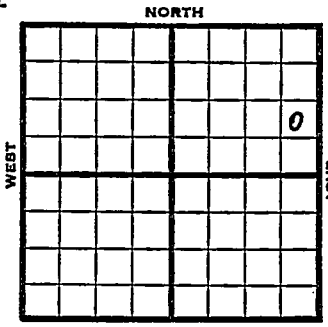

1953	Elev. 1916' REPORT
8/19	Location
8/26	"
9/2	10" @ 396' Drlg 3080'
9/9	Heeb 3242, Tor 3263, Doug 3277, Br. L. 3365, Lans 3376, B KC 3611, V 3630, Simp 3660, Arb 3711, TD 3715' Schl.
9/30	Spud 8-25-53 Oil Well TD 3725' 10" @ 396' Heeb 3242, Tor 3263, Doug 3277, Br. Lime 3365, Lans 3376, B KC 3611, Viola 3630, Simp 3660, Arb 3711 TD 3715' 7" @ 3711' CO to 3715' 34 go 4 hr. 50 A 19 go 2 hr. DD 3719' B/ 6 bo FU 300' oil 3 hr. 17 bo 1 hr. S/ 5 bo 2 hr. DD 3721

3711
1916
1795

OVER

1953

Information brought forward.

9/30 FU 600' oil 3 hr.
DD 3723
FU 1250' oil 1 hr.
DD 3725 FU 2000' oil 1 hr.
S/ 48 bo 1 hr. S/ 118 bo 5½ hr.
Comp. 84 bopd.

COMPLETED

FORM 275 FOR SALE BY KANSAS BLUE PRINT CO.


County Stafford State Kansas

Sec. 1 (Blk. Twp.) 22 (Sur. Rge.) 14W Map No.

Operator Phillips Pet.

Well No. 6 Farm Bordewick

Elev. Location NE SE NE

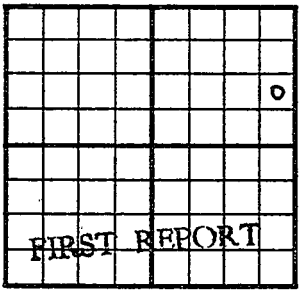

1650 Ft. From N Line NE

330 Ft. From E Line Quarter

1st. Report AUG 19 1953

Completion

Remarks Phillips - Contr.

Spudding Date

Drlg. Data Curtis Pool

Location

J. G. McGEHEE

FORM 275 FOR SALE BY KANSAS BLUE PRINT CO.


County Stafford State Kansas

Sec. 1 (Blk. Twp.) 22 (Sur. Rge.) 1 4W Map No.

Operator Phillips Pet.

Well No. 6 Farm Bordewick

Elev. 1916 Location NE SE NE

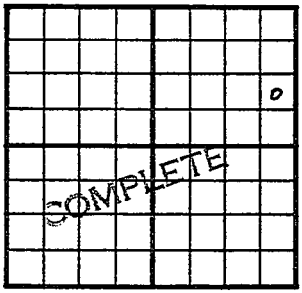

1650Ft. From N Line NE

330Ft. From E Line Quarter

1st. Report

Completion SEP 30 1953

Remarks Curtis Pool

Phillips - Contr.

Spudding Date 8-25-53

Drlg. Data Oil well TD 3725

10" @ 396 Heeb. 3242 Tor. 3263

Doug. 3277 Br. lime 3365 Lans. 3376

B KC 3611 Viola 3630 Simp. 3660

Arb. 3711 TD 3715 7" @ 3711 CO to 3715

34 go 4 hr. 50 A 19 go 2 hr.

DD 3719 B/ 6 bo FU 300' oil 3 hr.

17 bo 1 hr. S/ 5 bo 2 hr. DD 3721

FU 600' oil 3 hr. DD 3723 FU 1250' oil

1 hr. DD 3725 FU 2000' oil 1 hr.

S/ 48 bo 1 hr. S/ 118 bo 5½ hr.

Comp. 84 bopd

J. G. McGEHEE