

Stafford


FORM 51

KANSAS

Section 1 Township 22 Range 14W

Well No. #7 Bordewick

Company PhillipsPet.

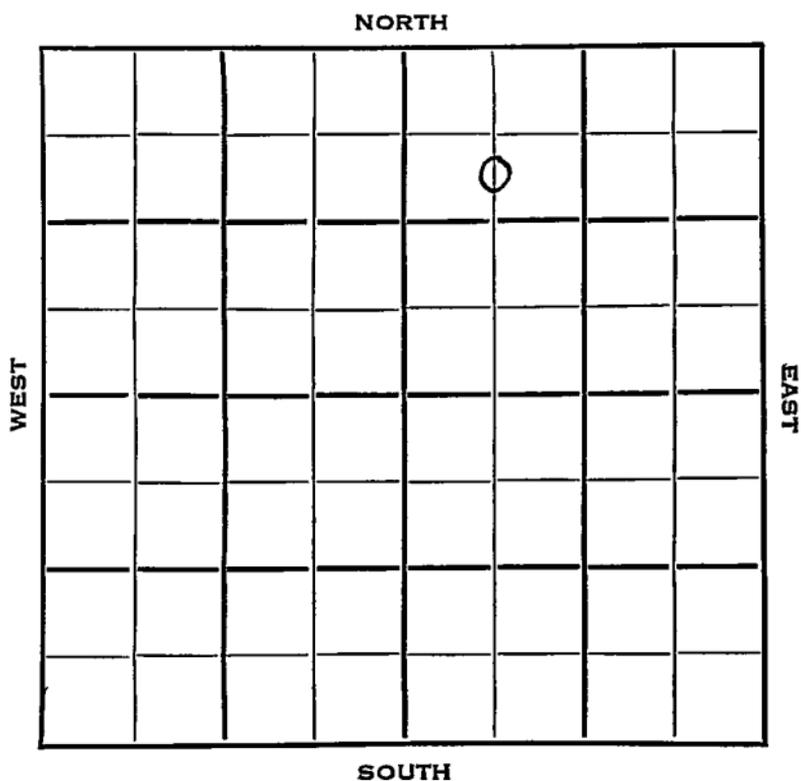

SEC.	TWP.	R.
1	22	11W ✓

WELL NO. 7 Bordewick FARM

COMPANY

Phillips Petr.

CONTRACTOR

Phillips Petr.

Curtis Pool


990 Ft. from N. Line

Ft. from S. Line

1980 Ft. from E. Line

Ft. from W. Line

C S L NW NE

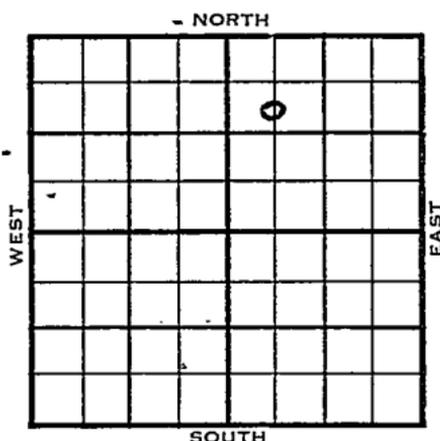

1953	ELEVATION	REPORT
	1919'	
9/30	Location	
10/21	10" @ 420' w/- Drlg 1775'	
10/28	Heeb 3264, Tor 3283, Br. L. 3385, Lans 3397 DST 3397'-3422', 1 hr, 190' gas, 110' so & gcm, 185# DST 3464'-73' 1 hr, 60' M 205# Drlg 3602'	
11/4	B KC 3632, V 3653, Simp 3681, Arb 3732, RTD 3740' 7" @ 3733' CO 3740 B/2 BO / 1 gw 4 hrs. 50 A B/ 1 1/2 BO 3 hrs. DD 3744 B/ 2-1/3 BO 1 hr.	
11/11	S/7 1/2 BO 5 Hrs. 500 A S/ 3 boph 4 hrs. S/ 6 boph.	
11/18	NR	

OVER

1953

12/2

Spud 10-17-53 Oil well TD 3740
10" @ 420 Heeb 3264' Tor. 3283'
Br. lime 3385' Lans 3397'
DST 3397-3422, open 1 hr rec 190'
gas, 110' SO & GCM 185#
DST 3464-73 open 1 hr rec 60' mud
205# B KC 3632' Viola 3653'
Simp. 3681 Arb. 3732'
TD 3740 7" @ 3733 CO to 3740
B/2 BO 1 GW 4 hr. 50 A
B/1½ BO 3 hr. DD 3744 B/2-1/3 BO
1 hr. S/7.4 BO 5 hr. 500 A
S/3 BOPH 4 hr. S/6 BOPH S/5 BOPH
P/54 BO 7 BW 12 hrs. P/80 BO 25 BW
24 hr.
Comp. 79 BOPD 24 BW

COMPLETED

