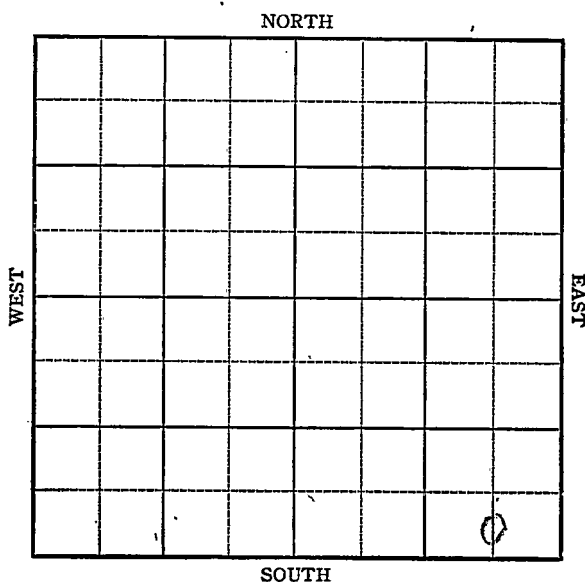


KANSAS

Stafford County

FORM 51 5M PETROL

Section 1 Township 22 Range 14WWell No. 1 WilsonCompany Tom Allan etal

KANSAS

Stafford County


Sec. 1 Twp. 22 R. 14WWell No. 1 Wilson FarmTom Allan etal Company

Curtis

Ft. from N. Line

330 Ft. from S. Line660 Ft. from E. Line

Ft. from W. Line

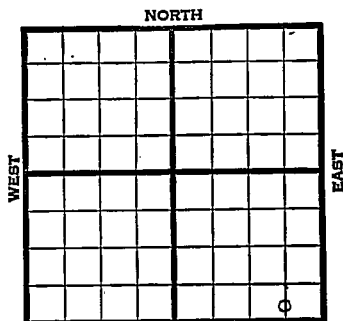

C S L SE SE Elev. 1935

SOUTH

1945

REPORT

5/9	RUR	
5/17	8" @ 385	
	Anhy	794
	Drlg. 1946	" "
5/24	Ft. Riley	1930
	Lans	3406
	Drlg. 3602	
5/31	Cong 3651	
	Simp 3686	
	Arb 3712	
	TD 3715	
6/8	Sat. 5" @ 3713' RUST	
	TD 3756- 1000' oil 500 acid	
	swb. 3 oil P.H. 4 hrs. 29 grav.	
6/14	swb 2 oil PH	
6/21	" " "	
7/3	Arb. 3712	
	5" @ 3713	
	TD 3756'	
	2000 acid.	
	Pump 40 Pot.	
	Grav. 30.0	

COMPLETED

Kansas Pool Name CurtisMap No. 82 Sec. 1 Twp. 22 R. 14WWell No. 1 WilsonTom Allan etal


Company

FIRST REPORT

Contractor

C S L SE SE

SECTION PLAT

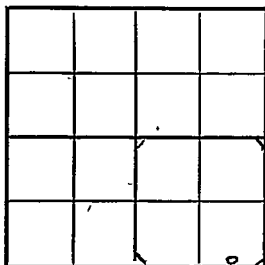 Ft. from N. Line330 Ft. from S. Line660 Ft. from E. Line Ft. from W. LineStafford CountyLocation Rig up

Drilling and Remarks:

RUR

RECORD

Cased in., ft.Sand Gas Oil Total Depth

PRODUCTION

1st 24 hrs. Nat. 1st 24 hrs. after shot Gas Cu. Ft.Dry Hole Abandoned

Date

MAY 9 194519S. J. LEWIS

Scout

KANSASKansas Pool Name CurtisMap No. 82 Sec. 1 Twp. 22 R. 14WWell No. 1 WilsonTom Allan etal

Company

COMPLETED

Contractor

C S L SE SE

E 1/1935
SECTION PLAT

 Ft. from N. Line330 Ft. from S. Line660 Ft. from E. Line Ft. from W. Line

Stafford County

Location Rig up

Drilling and Remarks:

Cr 837125" (83712)2000 acidPump 40 Rod.30° Gr.**RECORD**Cased in., ft.Sand Gas Oil Total Depth 9256**PRODUCTION**1st 24 hrs. Nat. 1st 24 hrs. after shot Gas Cu. Ft.Dry Hole Abandoned

Date

JUL 3 1945 19S. J. LEWIS Scout