


Section 1 Township 22 Range 14 W

Well No. # 1 Wilson

Company Westgate-Greenland

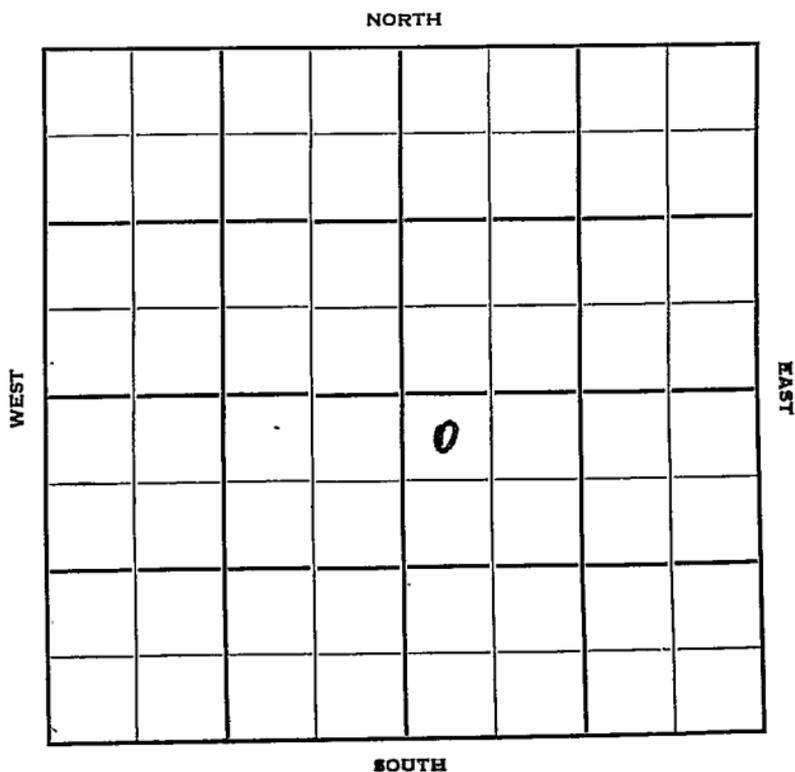

Stafford

KANSAS

Sec. 1 Twp. 22 R. 14W

Well No. #1 Wilson Farm

Westgate-Greenland Company


" Contractor

330 Ft. from N. Line

Ft. from S. Line

Ft. from E. Line

330 Ft. from W. Line

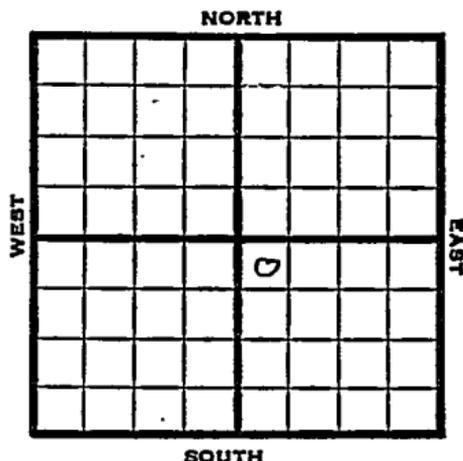

NW NW SE

1952

Elev. 1923' REPORT

10/8

Location

10/15

10" @ 313
Drlg. 2215'

10/22

Heeb 3270' Tor. 3289' Br. li 3392'
Lans. 3404'
DST 3405-54, 1 hr, 75' VSO & GCM,
60' GC & OCM
DST 3468-95, 1 hr, 145' mud 1140#
DST 3563-3600, 1 hr, 45' M 1080#
B KC 3638'
Drlg. 3663'

10/29

Spud 10-10-52

D&A

TD 3829'

10" @ 313'

Heeb. 3270', Tor. 3289', Br. lime 3392'
Lans 3404

DST 3405-54, opn 1 hr., rec. 75' vso
& gcm, 60' gc & ocm 370#

DST 3468-95, opn 1 hr., rec. 145' mud
1140#

DST 3563-3600, opn 1 hr., rec. 45' mud
1080#

B KC 3638, Marm. 3649, Viola 3672,
Simp. sh. 3747, Simp. sd. 3779, Arb.
3786'

TD 3829'

D&A

3404
1923
1481

ABANDONED

3786
1923
1863

