
FORM 51

Stafford KANSAS

Section 1 Township 22 Range 14 W

Well No. # 8 Bordewick

Company Phillips Pet.

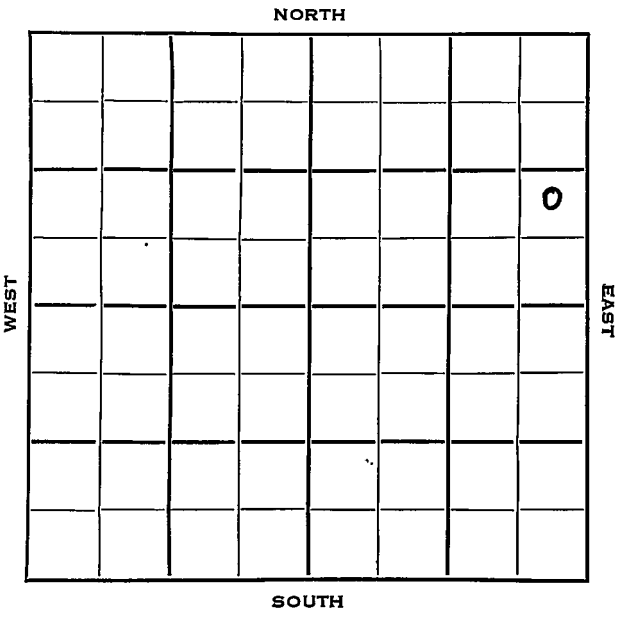

Stafford KANSAS

SEC.	TWP.	R.
1	22	14W ✓

WELL NO.

8 Bordewick FARM

COMPANY

Phillips Petr.

CONTRACTOR

Badger


Curtis Pool

1550 Ft. from N. Line

Ft. from S. Line

330 Ft. from E. Line

Ft. from W. Line

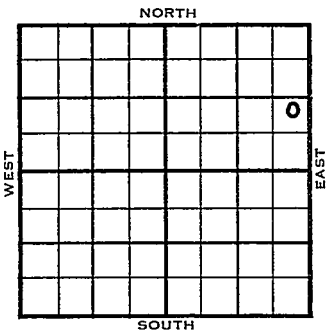

NE SE NE (Twin well)

1953	ELEVATION 1918'	REPORT
11/24	MIR	
1954 1/13	Spud 11-23-53 Oil well TD 3640' 8-5/8" @ 394 Heeb 3243' Tor. 3263' Doug. 3275' Br lime 3367' Lans 3379 B KC 3612' TD 3640' Viola 3630' 5" @ 3634 CO to 3607' 35/3591-96 35/3564-67 35/3544-49 FU 1262' fluid. 500 A S/31.62 BW 6 hr. Sq. perf. CO to 3542' 32/3504-12 500 A S/105 BO 8 hr. PB 3480' 56/3454-68 500 A S/64 BW 1½ hr. DO to 3459 28/3443-50 B/1 BW 5 hr. 500 A S/31 BO 5 hr. 1500 A S/19 BO 118 BW 7 hr. Sq. CO to 3434' 16/3427-31 12/3419-22 500 A ½ BW 3 hr. 16/3406-10 B/1/3 BO 1/3 BW 4 hr. 500 A S/43 BO 3 hr. CO to 3439 CO to 3538 36/3523-32 Comp. 220 BOPD 6 BW	

COMPLETED

DX-78

FORM 275 FOR SALE BY KANSAS BLUE PRINT CO.


County Stafford State Kansas

Sec. 1 (Blk. Twp.) 22 (Sur. Rge.) 14W Map No.

Operator Phillips Pet.

Well No. 8 Farm Bordewick

Elev. Location. NE SE NE

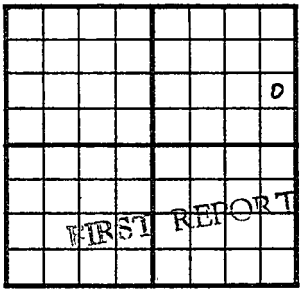

1550 Ft. From N Line NE

330 Ft. From E Line Quarter

NOV 24 1953

1st. Report

Completion

Remarks

Spudding Date

Drlg. Data Curtis Pool

M I R

J. G. McGEHEE

FORM 275 FOR SALE BY KANSAS BLUE PRINT CO.


County Stafford State Kansas

Sec. 1 (Blk. Twp.) 22 (Sur. Rge.) 14W Map No.

Operator Phillips Pet.

Well No. 8 Farm Bordewick (twin well)

Elev. 1918 Location NE SE NE

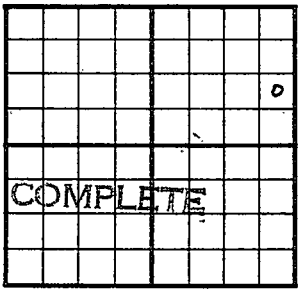

1550Ft. From N Line NE

330Ft. From E Line Quarter

1st. Report

Completion JAN 1 3 1954

Remarks Curtis Pool

Badger - Contr.

Spudding Date 11-23-53

Drlg. Data Oil well TD 3640

8 5/8" @ 394 Heeb. 3243 Tor. 3263

Doug. 3275 Br. lime 3367 Lans. 3379

B KC 3612 TD 3640 Viola 3630

5" @ 3634 CO to 3607 35/ 3591-96

35/ 3564-67 35/ 3544-49 FU 1262' fluid

500 A S/ 31.62 bw 6 hr.

sq. perf. CO to 3542 32/ 3504-12

500 A S/ 105 bo 8 hr. PB 3480

56/ 3454-68 500 A S/ 64 bw 1½ hr.

DO to 3459 28/ 3443-50 B/ 1 bw 5 hr.

500 A S/ 31 bo 5 hr. 1500 A -

S/ 19 bo 118 bw 7 hr. sq. CO to 3434

16/ 3427-31 12/ 3419-22 - 500 A

½ bw 3 hr. 16/ 3406-10 B/ 1/3 bo


J. G. McGEHEE

Drlg. Data

1/3 bw 4 hr. 500 A S/ 43 bo 3 hr.

CO to 3439 CO to 3538 36/ 3523-32

Comp. 220 bopd 6 bw

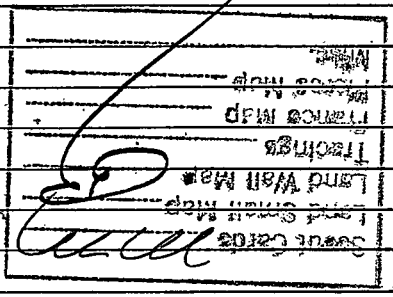

JAN 4 9 1954