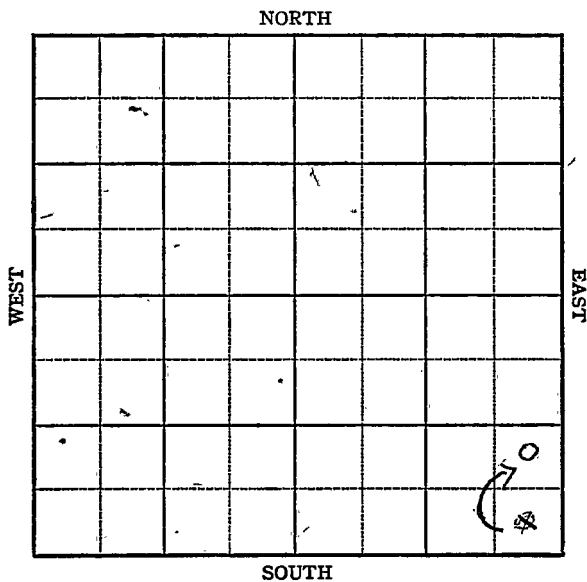


KANSAS

Stafford county

Section 1 Township 22 Range 14-WWell No. ~~#1~~ ^{#3} WilsonCompany Tom Allan

KANSAS

Stafford County

Sec. 1 Twp. 22 R. 14W

Well No. #3 4 Wilson Farm

Tom Allan Company

Curtis

Ft. from N. Line

990

Ft. from S. Line


~~330~~

330

Ft. from E. Line

Ft. from W. Line

~~SE/C~~ NE SE SE

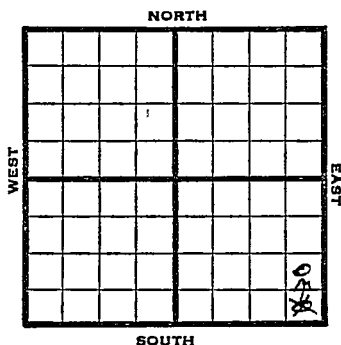

1947

REPORT

1/2	8" @ 368'		
	Drlg 3300'		
1/8	Lans 3394'		
	Gong 3640'		
	Simp 3750'		
	Arb 3769'		
	TD 4027-		
	5" @ 3855,	SWD	
1/15	" "	"	
1/21	" "	"	
1/29	TD 4027'		
	Arb. 3833		
	5" @ 3855		
	SWD		

3833

ABANDONED

Kansas KANSAS

Curtis

Map No. 82 Sec. 1 Twp. 22 R. 14WWell No. 4 WilsonTom Allan Company

FIRST REPORT

Contractor

SE/C

SECTION PLAT

			0

 Ft. from N. Line330 Ft. from S. Line330 Ft. from E. Line Ft. from W. Line

Stafford County

Location Rig up

Drilling and Remarks:

8" @ 368

drlg. 3300

RECORD

Cased in., ft.Sand Gas Oil Total Depth

PRODUCTION

1st 24 hrs. Nat. 1st 24 hrs. after shot Gas Cu. Ft.Dry Hole Abandoned

Date

JAN 2 1947 19

S. J. LEWIS Scout

Map No. 82 Sec. 1 Twp. 22 R. 14W

Well No. 3 Wilson

Tom Allan Company

CORRECTION Contractor

NE SE SE

SECTION PLAT

			o

 Ft. from N. Line

990 Ft. from S. Line

330 Ft. from E. Line

 Ft. from W. Line

Stafford County

Location

Rig up

Drilling and Remarks:

Reported SE $\frac{1}{4}$ C
and as #4 Wilson

RECORD

Cased in., ft.

Sand

Gas

Oil

Total Depth

PRODUCTION

1st 24 hrs. Nat.

1st 24 hrs. after shot

Gas Cu. Ft.

Dry Hole

Abandoned

Date

JAN 8 1947 19 S. J. LEWIS Scout

Map No. 82 Sec. 1 Twp. 22 R. 14W

Well No. 3 Wilson

Tom Allan


Company

ABANDONED

Contractor

NE SE SE

SECTION PLAT

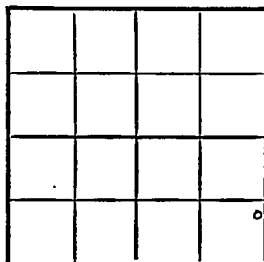

 Ft. from N. Line

990 Ft. from S. Line

330 Ft. from E. Line

 Ft. from W. Line

Stafford County

Location

Rig up

Drilling and Remarks:

CE 3835
5' 3835
BWD

RECORD

Cased in., ft.

Sand

Gas

Oil

Total Depth 4027

PRODUCTION

1st 24 hrs. Nat.

1st 24 hrs. after shot

Gas Cu. Ft.

Dry Hole

Abandoned

Date

JAN 29 1947 19

S. J. LEWIS

Scout