

Sec. 1 Twp. 22 R. 14W

Well No. #2 Edith Wright Farm

Continental Oil Company

Lohman & Johnson Contractor

Smallwood Pool


Ft. from N. Line

330 Ft. from S. Line

Ft. from E. Line

990 Ft. from W. Line

SE SW SW

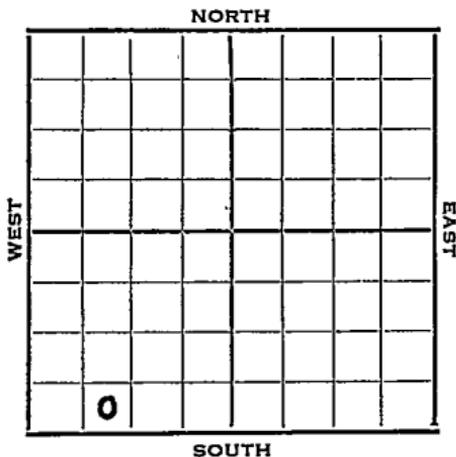

1953 Elev. 1926' REPORT

2/18 Spud 2-13-53
10" @ 361
Drlg. 2122

2/26 Heeb 3275 Br Li 3401 Lans 3412 DST 3563-
77 1 Hr. 15' Hly OCM 20' SOCM 165 #
V 3662 DST 3661-73 1 Hr. 8'M ARB 3746
DST 3746 - 51

3/12 DST 3746-51, 1 hr., 8' M
DST 3747-57, 1 hr., 95' hly
OM ? 500A
RTD 3806, Schl
6" 3805
71/3752-71, FU 1050' oil 7 hrs.
S/3 BO 1 hr., 500A
S/40 BOPH 4 hrs.

3/19 NR
3/26 NR
4/2 "
4/9 NR

OVER

#2 Edith Wright

1953
4/15

Spd 2-13-53

Oil Well

TD 3806

10" @ 361

Heeb 3275, Br lime 3401, Lans 3412

DST 3563-77, opn 1 hr., rec. 15^a

hocm, 20' socm, 165#

Viola 3662

DST 3661-73, opn 1 hr., rec. 8' mud
O#

Arb. 3746

DST 3746-51, opn 1 hr., rec. 8' mud

DST 3747-57, opn 1 hr., rec. 95' m

vhocm, 500#

TD 3806

6" @ 3805

71/3752-71, FU 1050' dil, 7 hrs.

S/3 bo 1 hr., 500A

S/40 boph 4 hrs.

Comp. 197 bopd 197 bw

COMPLETED

