
FORM 51

Pawnee KANSAS

Section 1 Township 22 Range 15W

Well No. 1 McDonnell

Company Tom Allen

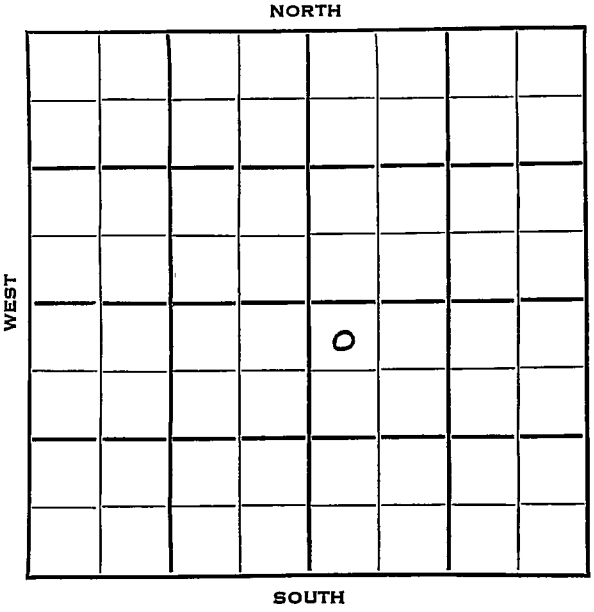

Pawnee KANSAS

SEC.	TWP.	R.
1	22	15 W

WELL NO.

1 McDonnell FARM

COMPANY

Tom Allen

CONTRACTOR

Wildcat

330 Ft. from N. Line


Ft. from S. Line

Ft. from E. Line

330 Ft. from W. Line

NW NW SE

Stanolind - DHM

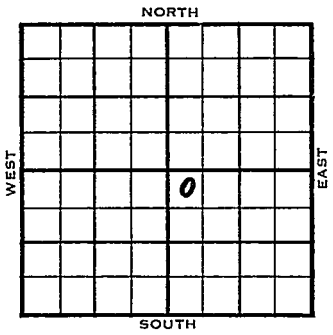

1953	ELEVATION 1964'	REPORT
11/11		Spud 11-8-53 8" @ 331 Drlg. 1360'
11/18		Top 2986', Heeb 3353' Drlg 3398'
11/24		Spud 11-8-53 D & A TD 3939' 8" @ 331 Top 2986 Heeb 3353 Br lime 3469 Lans. 3478 DST 3493-3515 open 1 hr rec 40' mud SS dead oil Cong. 3779 DST 3770-3821 open 1 hr. rec 45' mud SSO 80# Simp. 3835 Arb. 3890 TD 3937 Schl tops: Heeb 3356 Br lime 3471 Lans 3480 Viola 3784 Simp 3838 Arb. 3890 TD 3939' D & A ABANDONED

DX-78

FORM 275 FOR SALE BY KANSAS BLUE PRINT CO.


County Pawnee State Kansas

Sec. 1 (Blk. Twp.) 22 (Sur. Rge.) 15W Map No.

Operator Tom Allen

Well No. 1 Farm McDonnell

Elev. Location NW NW SE

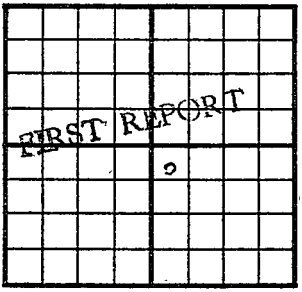

330 Ft. From N Line SE

330 Ft. From W Line Quarter

1st. Report NOV 11 1953

Completion

Remarks Stanolind - DHM

Spudding Date 11-8-53

Drlg. Data Wildcat

8" @ 331 drlg. 1360

J. G. McGEHEE

FORM 275 FOR SALE BY KANSAS BLUE PRINT CO.


County Pawnee State Kansas

Sec. 1 (Blk. Twp.) 22 (Sur. Rge.) 15W Map No.

Operator Tom Allen

Well No. 1 Farm McDonnell

Elev. 1964 Location NW NW SE

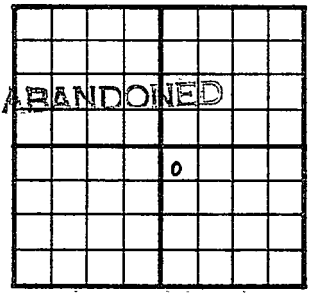

330 Ft. From N Line SE

330 Ft. From W Line Quarter

1st. Report

Completion NOV 24 1953

Remarks Wildcat

Spudding Date 11-8-53

Drlg. Data D & A TD 3939

8" @ 331 Top. 2986 Heeb. 3353

Br. lime 3469 Lans. 3478 DST 3493-3515

open 1 hr. Rec. 40' mud SS dead oil

Cong. 3779 DST 3770-3821 open 1 hr.

Rec. 45' mud SSO 80# Simp. 3835

Arb. 3890 TD 3937 SCHLUMBERGER TOPS

Heeb. 3356 Br. lime 3471 Lans. 3480

Viola 3784 Simp. 3838 Arb. 3890

TD 3939

D & A

J. G. McGEHEE