


Section 1 Township 22 Range 16 W

Well No. # 2 Malin

Company Iron Drlg.

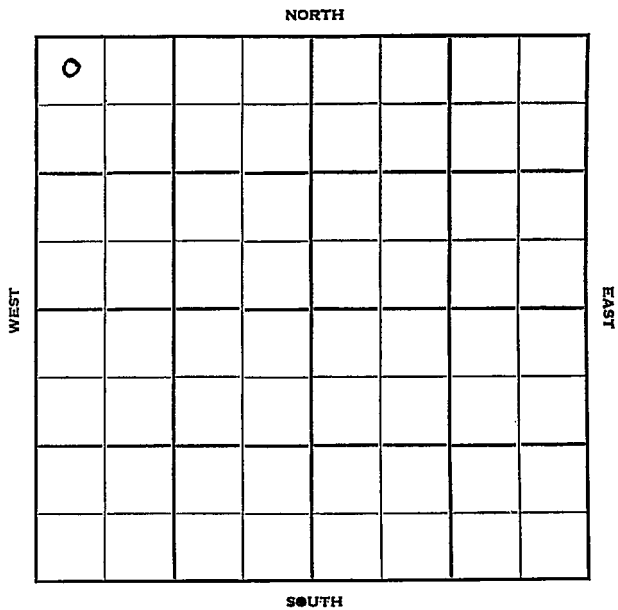

Pawnee

KANSAS

Sec. 1 Twp. 22 R. 16W

Well No. #2 Malin Farm

Iron Drlg. Company

Evers Contractor


330 Ft. from N. Line

_____ Ft. from S. Line

_____ Ft. from E. Line

330 Ft. from W. Line

NW NW NW

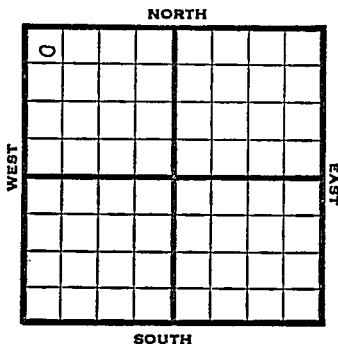

1952

Elev. 1980' REPORT

2/13

Spud 2-8-52

Anhy 950'

8" @ 970'

Drlg. 1030'

2/20

Drlg. 3225'

3/5

9/3861-62 Fill up 2300' oil 1/2 hr.

F thru csg 23 BOPH for 5 hrs.

Ran tubing

F 25 BOPH Setting tanks

3/12

"

3/19

Setting Tanks

3/26

Spud 2-8-52

Oil well TD 3953' - Anhy 950'

8" @ 970' Simp. 3862' Arb. 3919'

TD 3953' 5" @ 3953 9/3861-62

FU 2300' oil 30 min.

F/23 BOPH 5 hr.

Comp. BHB 3000 BOPD

COMPLETED

County Pawnee State Kansas

Sec. 1 (Blk.) 22 (Sur.) 16W Map No.

Operator Iron Drlg.

Well No. 2 Farm Malin

Elev. _____ Location NW NW NW

FIRST REPORT									

330 Ft. From N Line NW

330 Ft. From W Line Quarter

lst. Report FEB 13 1952

Completion _____

Remarks _____

Spudding Date 2-8-52

Drlg. Data Evers

Anhy 950 8" @ 970 Drlg. 1030

J. G. McGEHEE

County Pawnee State Kansas

Sec. 1 (Blk. Twp.) 22 (Sur. Rge.) 16W Map No.

Operator Iron Drlg.

Well No. 2 Farm Malin

Elev. 1980 Location NW NW NW

D				

330 Ft. From N Line NW

330 Ft. From W Line Quarter

1st. Report

Completion MAR 26 1952

Remarks Evers Pool

Spudding Date 2-8-52

Drlg. Data Oil well TD 3953

Anhy 950 8" @ 970 Simp. 3862

Arb. 3919 TD 3953 5" @ 3953

9/ 3861-62 FU 2300' oil 30 min.

F/ 23 boph 5 hr. Comp. BHB 3000 bopd