

# KANSAS

Form 51-5M-7-39-Palace


Stafford

Section 1 Township 22 Range 12-W

Well No. #1 Helmers

Company Stanolind

Sittner Pool

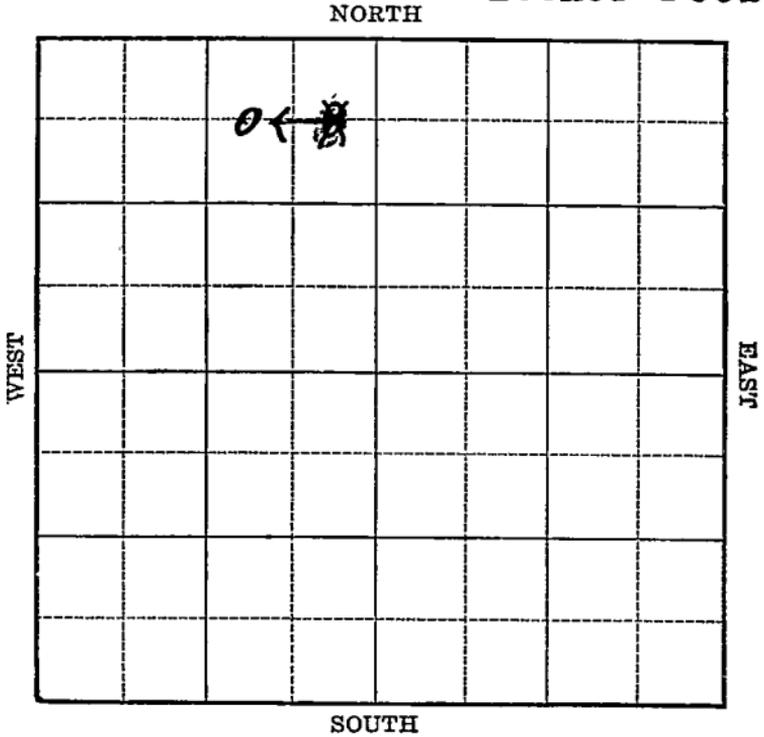

Sec. 1 Twp. 22 R. 12-W

Well No. #1 Helmers Farm

Stanolind Company

Company

(Sittner)

660 Ft. from N. Line


Ft. from S. Line

990  
~~330~~

Ft. from E. Line

Ft. from W. Line

Elev. 1809

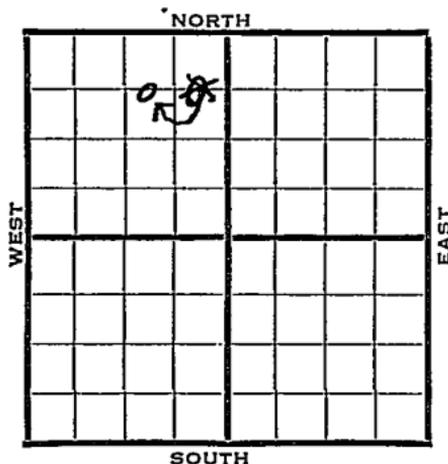

1940	REPORT
3/27	Location
4/3	"
4/12	R. R.
4/19	8" - 232' Anhy 563'
	Drlg. 1625'
4/25	Lansing <del>3240'</del> 3227'
5/2	Lansing 3227' (Corrected)
	Viola 3477' Simp. 3512'
	Arb. 3554-58' T.D. 5 1/2" - 3554'
	200' per hour filling. C.O.
5/9	T.D. 3563' 4300 acid.
	Swab 88 bbls. 4 hours.
5/15	Arb. 3554'
	5" - 3554'
	T.D. 3563'
	7000 acid.
	Depthograph potential 499 bbls.
	<b>COMPLETED</b>

Map No. 46 Sec. 1 Twp. 22 R. 12W

Well No. 1 Helmers

Stanolind Company

Contractor

**FIRST REPORT**

**SECTION PLAT**


C E L NE NW

660 Ft. from N. Line

\_\_\_\_\_ Ft. from S. Line

330 Ft. from E. Line

\_\_\_\_\_ Ft. from W. Line

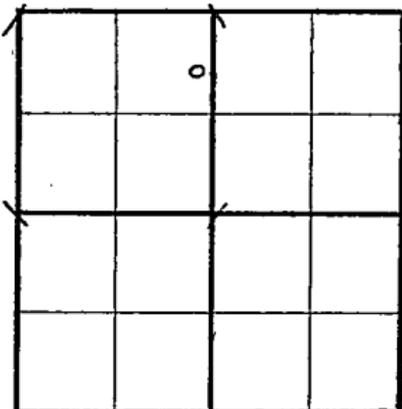

**SITPNER POOL**

Location X

Rig up \_\_\_\_\_

Drilling and Remarks: \_\_\_\_\_

**RECORD**

Cased \_\_\_\_\_ in., \_\_\_\_\_ ft.

Sand \_\_\_\_\_

Gas \_\_\_\_\_

Oil \_\_\_\_\_

Total Depth \_\_\_\_\_

**PRODUCTION**

1st 24 hrs. Nat. \_\_\_\_\_

1st 24 hrs. after shot \_\_\_\_\_

Gas \_\_\_\_\_ Cu. Ft.

Dry Hole \_\_\_\_\_

Abandoned \_\_\_\_\_

Date

MAR 27 1940<sub>19</sub>

S. J. LEWIS

Scout

Map No. 46 Sec. 1 Twp. 22 R. 12W

Well No. 1 Helmers

Stanolind Company

CORRECTION Contractor

**SECTION PLAT**

C W L NE NW

660 Ft. from N. Line

\_\_\_\_\_ Ft. from S. Line

990 Ft. from E. Line

\_\_\_\_\_ Ft. from W. Line

**SITTNER POOL**


Location \_\_\_\_\_

Rig up \_\_\_\_\_

Drilling and Remarks:

**Reported**

**C E L NE NW**

**RECORD**

Cased \_\_\_\_\_ in., \_\_\_\_\_ ft.

Sand \_\_\_\_\_

Gas \_\_\_\_\_

Oil \_\_\_\_\_

Total Depth \_\_\_\_\_

**PRODUCTION**

1st 24 hrs. Nat. \_\_\_\_\_

1st 24 hrs. after shot \_\_\_\_\_

Gas \_\_\_\_\_ Cu. Ft.

Dry Hole \_\_\_\_\_

Abandoned \_\_\_\_\_

Date

APR 16 1940<sub>19</sub>

S. J. LEWIS Scout

Map No. 46 Sec. 1 Twp. 22 R. 12W

Well No. 1 Helmers

Stanolind Company

Contractor

**COMPLETED**

**SECTION PLAT**

660 C W $\frac{1}{2}$  NE NW  
Ft. from N. Line

\_\_\_\_\_ Ft. from S. Line

990 Ft. from E. Line

\_\_\_\_\_ Ft. from W. Line

	6		

**SITTMER POOL**

Location \_\_\_\_\_

Rig up \_\_\_\_\_

Drilling and Remarks:

*CR 83554*  
*5" @ 3554*  
*700 acid*  
*Geothograhk P.D.*  
*499*

**RECORD**

Cased \_\_\_\_\_ in., \_\_\_\_\_ ft.

Sand \_\_\_\_\_

Gas \_\_\_\_\_

Oil \_\_\_\_\_

Total Depth 3563

**PRODUCTION**

1st 24 hrs. Nat. \_\_\_\_\_

1st 24 hrs. after shot \_\_\_\_\_

Gas \_\_\_\_\_ Cu. Ft.

Dry Hole \_\_\_\_\_

Abandoned \_\_\_\_\_

Date

MAY 15 1940<sub>19</sub>

S. J. LEWIS Scout