


FORM 51 5M 4-41 PETROL

Section 1 Township 22 Range 12-W

Well No. 1 Helmers

Company stanolind

NORTH Sittner Pool

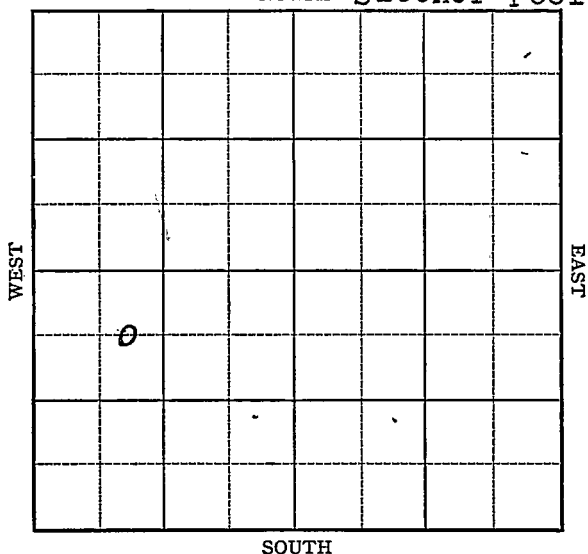

Sec. 1 Twp. 22 R. 12-WWell No. #1 Helmers FarmStanolind

Company

(Sittner)


660 Ft. from N. Line

Ft. from S. Line

Ft. from E. Line

990 Ft. from W. Line

Elev. 1824

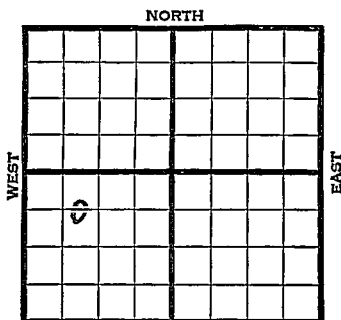

SOUTH

REPORT

194

5/21 Rot ary.

5/28 8" - 246' Anhy 579'

Drlg. 1140'

6/5 Lans. 3240' Drlg. 3432'

6/12 Viola 3488' Arb. 3568-75½' T.D.
5½" - 3568½' RUST.

6/19 T.D. 3575½' 500 acid.

Flow 215 oil in 3 hours.

6/21 Bottom hole bomb potential 17,695 bbls
Maximum allowed 3000 bbls. (Tel)

6/25 Arb. 3568'

5" - 3568½'

T.D. 3575½'

500 acid.

Bomb potential 17,695 bbls.

Maximum 3000 bbls.

40. Gravity

COMPLETED

Map No. 46 Sec. 1 Twp. 22 R. 12WWell No. 1 HelmersStanolind

Company

FIRST REPORT

Contractor

SECTION PLAT**C E L N W S W**660 Ft. from N. Line Ft. from S. Line Ft. from E. Line990 Ft. from W. Line

SITTNER POOLLocation Rig up

Drilling and Remarks:

Rotary**RECORD**Cased in., ft.Sand Gas Oil Total Depth **PRODUCTION**1st 24 hrs. Nat. 1st 24 hrs. after shot Gas Cu. Ft.Dry Hole Abandoned

Date

MAY 21 1941 19S. J. LEWIS Scout

Map No. _____ Sec. 1 Twp. 22 R. 12WWell No. 1 HelmersStanolind

Company

COMPLETED

Contractor

SECTION PLAT

C E L NW SW

660 Ft. from N. Line

_____ Ft. from S. Line

_____ Ft. from E. Line

990 Ft. from W. Line

MAX POOL

Location _____

Rig up _____

Drilling and Remarks:

*Cor 8 3568**5" @ 3568 1/2**500 acc'd**Bont 12 17695**May 3000**400/G*

RECORD

Cased _____ in., _____ ft.

Sand _____

Gas _____

Oil _____

Total Depth 3575 1/2

PRODUCTION

1st 24 hrs. Nat. _____

1st 24 hrs. after shot _____

Gas _____ Cu. Ft.

Dry Hole _____

Abandoned _____

Date .

JUN 25 1941

19

S. J. LEWIS

Scout