


Section 1 Township 22 Range 12W

Well No. #1 Helmers

Company M & L Oil

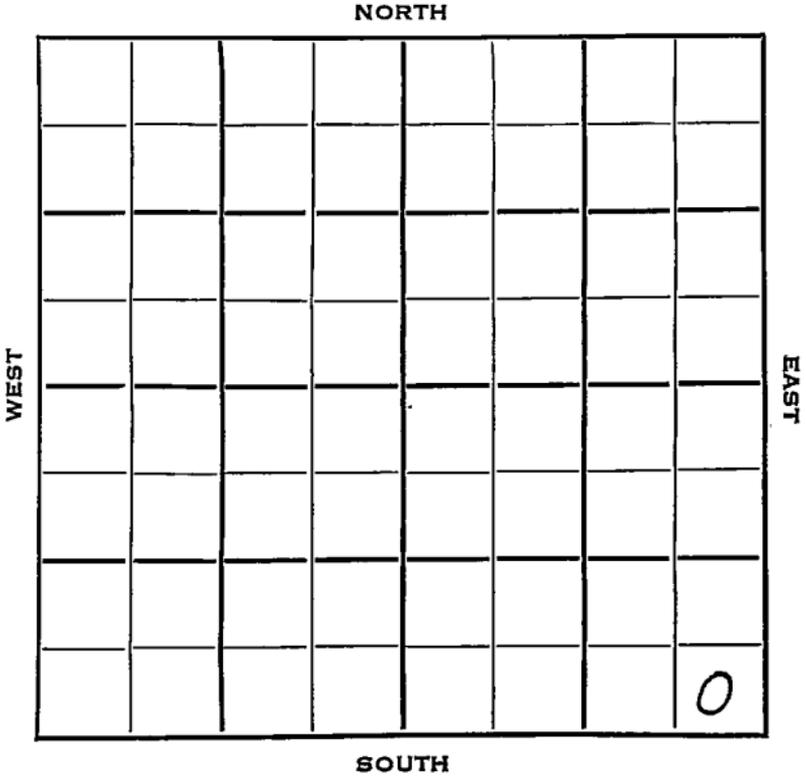

Sec. 1 Twp. 22 R. 12W

Well No. #1 Helmers Farm

M & L Oil Company

Birmingham & Bartlett Contractor
Heyen Pool


_____ Ft. from N. Line

330 Ft. from S. Line

330 Ft. from E. Line

_____ Ft. from W. Line

SE SE SE

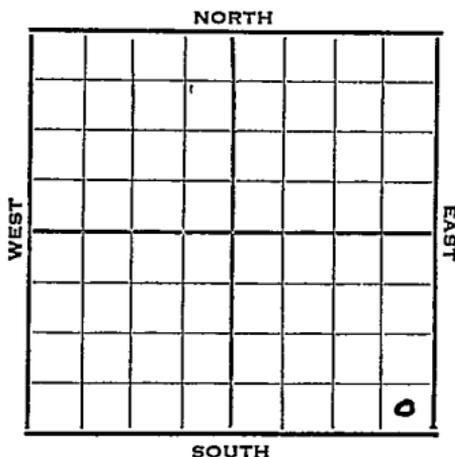

1953 Elev. 1789' REPORT

7/8 Spud 7-3-53
8" @ 225' w/200 sks
Anhy 540'
Drlg 2085'

7/15 Spud 7-3-53
D&A
TD 360L
8" @ 225'
Anhy 540, Heeb 3094, Br lime 3203,
Lans 3230, B KC 3478, Cong 3505,
Viola 3553, Simp 3569
TD 360L
D&A

ABANDONED

