


Section 1 Township 22 Range 12W

Well No. #3 Helmers

Company Laura Jane Oil

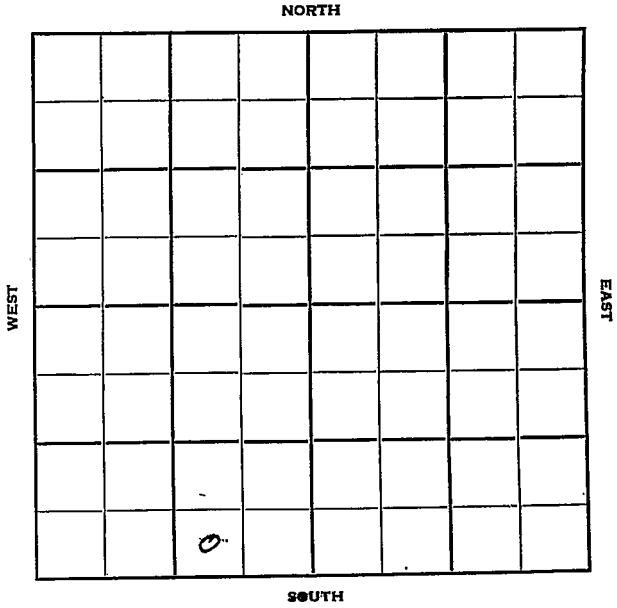

Stafford

KANSAS
12W

Sec. 1 Twp. 22 R. ✓

Well No. #3 Helmers Farm

Laura Jane Oil Company

Laura Jane Oil - Contr. Contractor
Max Pool


 Ft. from N. Line

330' Ft. from S. Line

990' Ft. from E. Line

 Ft. from W. Line

SW SE SW

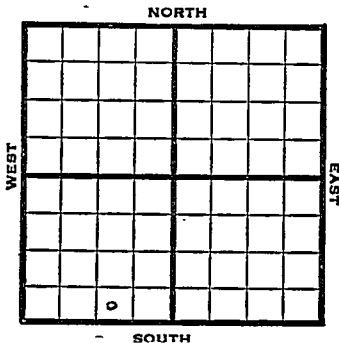

1950. Elev 1824' REPORT

12/6 Spud 11-30-50
8" @ 192
Anhy 455
Drlg. 3056'

12/13 8" @ 192
Anhy 455 Lans 3261
DST 3376-90 opn 15 min rec 100' mud
Viola 3530
DST 3522-51 opn 1/2 hr rec 50' socm
Simp 3574 Arb 3630-35 TD
D&A TD 3635'

ABANDONED

