

KANSAS

Stafford


FORM 51 5M 10-41 PETROL

Section 1 Township 22 Range 12-W

Well No. #4 Helmers

Company Stanolind

NORTH Sittner Pool

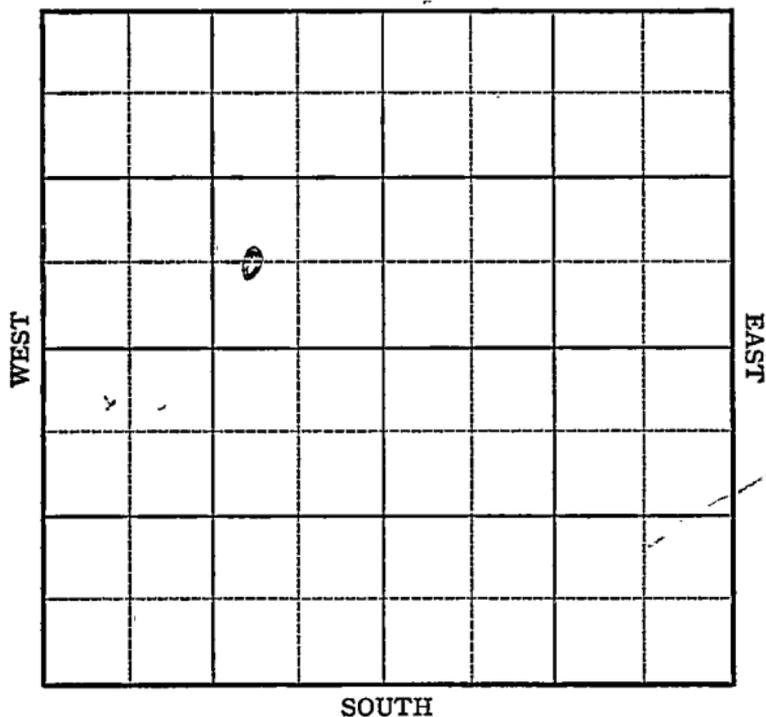

Sec. 1 Twp. 22 R. 12-W

Well No. #4 Helmers Farm

Stanolind Company

(Sittner)


_____ Ft. from N. Line

660 Ft. from S. Line

990 Ft. from E. Line

_____ Ft. from W. Line

Elev. 1818

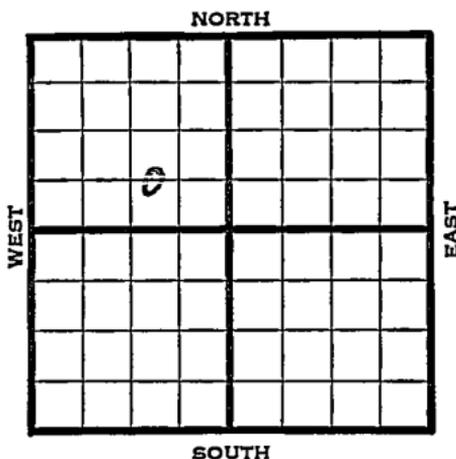

1942	REPORT
4/22	Drlg. 42'
4/29	8" - 267' Drlg. 2750'
5/6	Lans. 3230' Arb. 3559'
	T.D. 3565' Run casing.
5/13	4" - 3560' 500W acid.
5/20	T.D. 3568 $\frac{1}{2}$ ' 1000 acid. S.W.
	P.B. to 3567'
5/27	Arb. 3559'
	4" - 3560'
	T.D. 3568 $\frac{1}{2}$ '
	P.B. to 3567'
	1000 acid.
	Depthograph potential 688 bbls., fluid
	583 oil & 101 water.
	40. Gravity
	COMPLETED

Stafford

Map No. 46 Sec. 1 Twp. 22 R. 12W

Well No. 4 Helmers

Stanolind Company

FIRST REPORT

Contractor

C WL SE NW

SECTION PLAT

	o		

_____ Ft. from N. Line

660 Ft. from S. Line

990 Ft. from E. Line

_____ Ft. from W. Line

SITTNER POOL

Location _____

Rig up _____

Drilling and Remarks:

Drlg. 42'

RECORD

Cased _____ in., _____ ft.

Sand _____

Gas _____

Oil _____

Total Depth _____

PRODUCTION

1st 24 hrs. Nat. _____

1st 24 hrs. after shot _____

Gas _____ Cu. Ft.

Dry Hole _____

Abandoned _____

Date

APR 22 1942 19

S. J. LEWIS Scout

Stafford

Map No. 46 Sec. 1 Twp. 22 R. 12W

Well No. 4 Helmers

Stanolind Company

COMPLETED Contractor

C WL SE NW

SECTION PLAT

	0		

_____ Ft. from N. Line

660 Ft. from S. Line

990 Ft. from E. Line

_____ Ft. from W. Line

SITNER POOL

RECORD

Location _____

Cased _____ in., _____ ft.

Rig up _____

Sand _____

Drilling and Remarks:

Gas _____

Cr 9555

Oil _____

4" @ 9560

Total Depth 3568 1/2

PB 3567

1000 acid

Depth 3568 ft

583 oil 101 Water

40 @ 95

PRODUCTION

1st 24 hrs. Nat. _____

1st 24 hrs. after shot _____

Gas _____ Cu. Ft.

Dry Hole _____

Abandoned _____

Date

MAY 27 1942 19

S. J. LEWIS Scout