


Section 1 Township 22 Range 12 W

Well No. # 2 Mellies

Company M & L Oil Co.

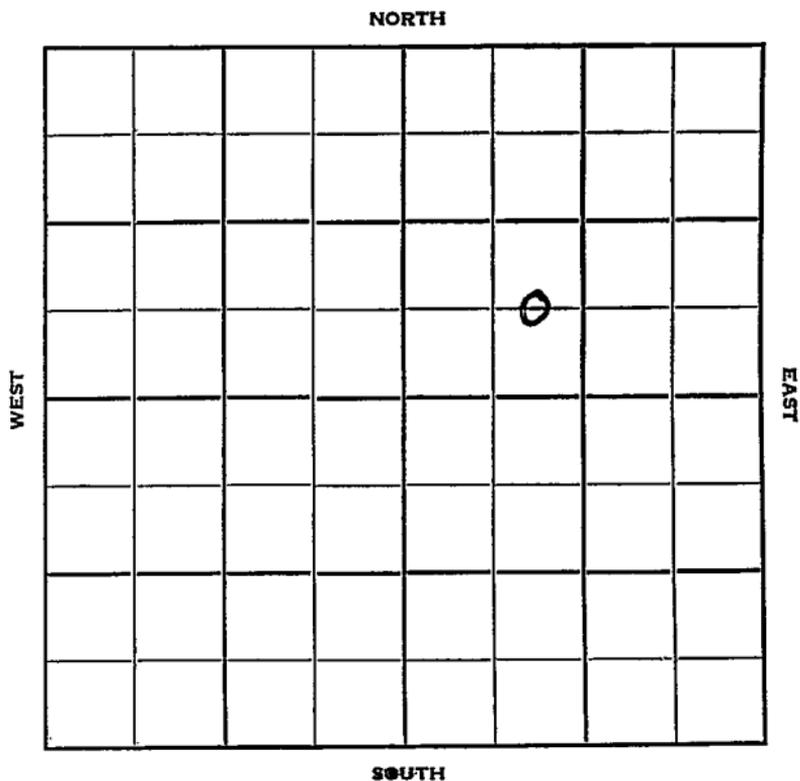

Sec. 1 Twp. 22 R. 12W

Well No. #2 Mellies Farm

M & L Oil Co. Company

Mallard Drlg. Contractor
Max Pool


Ft. from N. Line

660 Ft. from S. Line

Ft. from E. Line

990 Ft. from W. Line

C E L SW NE

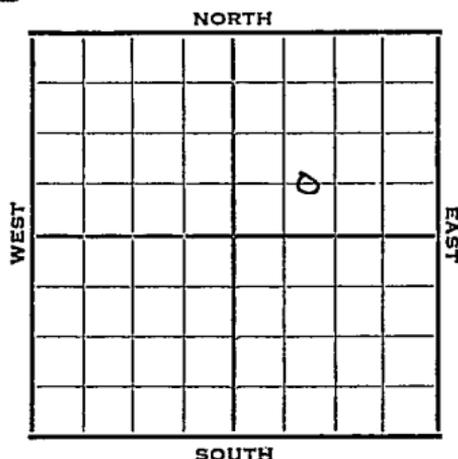

1952 Elev. 1809'

REPORT

6/11 Spud 6-4-52
8" @ 210'
Drlg. 2960'

6/18 Br li 3192' Lans. 3216'
DST 3280-3304, 1 hr, 300' muddy oil
1100#
DST 3345-59 1 hr, 45' OCM
DST 3364-98, 1/2 hr, 3,100,000 gas
65' OCM, 1200#
Simp. 3516' Arb. 3559'
DST 3558-61, 1 hr, 800' oil
TD 3563' 5" @ 3558'

6/25 D.P.

7/2 CO 3531' 59/3285-3302 SSO & W
1000 A S/11 BOPH 2500 A

7/9 POP

7/17 NR

7/24 "

7/30 Spud 6-4-52 Oil Well TD 3563
8" @ 210 Br Li 3192 Lans. 3216
DST 3280-3304 open 1 hr. rec. 300'
muddy oil 1100#
DST 3345-59 open 1 hr. rec. 45' ocm
200# DST 3364-98 open 1/2 hr. rec.
3,100,000 gas 65' ocm 1200#
Simp. 3516 Arb. 3559

OVER

1952

7/30 DST 3558-61 open 1 hr. rec. 800'
oil TD 3563 5" @ 3558
CO to 3531 59/ 3285-3302
SSO & W 1000 A S/ 11 boph
2500 A Comp. 77 bopd 40% wtr.

COMPLETED

County **Stafford** State **KANSAS**

Sec. **1** (Blk. Twp.) **22** (Sur. Rge.) **12W** Map No.

Operator **M & L Oil Co.**

Well No. **2** Farm **Mellies**

Elev. **1809** Location **C E L SW NE**

660 Ft. From **S** Line **NE**

990 Ft. From **W** Line **Quarter**

Ist. Report **JUN 11 1952**

Completion _____

Remarks _____

Mallard Drlg. - Contr.

Spudding Date **6-4-52**

Drlg. Data **Max Pool**

8" @ 210 drlg. 2960

J. G. McGEHEE

County Stafford State Kansas

Sec. 1 (Blk. 22) (Sur. 12W) Twp. (Rge.) Map No.

Operator M & L Oil Co.

Well No. 2 Farm Mellies

Elev. 1809 Location C E L SW NE

660 Ft. From S Line NE

990 Ft. From W Line Quarter

1st. Report

Completion JUL 30 1952

Remarks Max Pool

Mallard Drlg. - Contr.

Spudding Date 6-4-52

COMPLETE

Drlg. Data Oil well TD 3563

8" @ 210 Br. lime 3192 Lans. 3216

DST 3280-3304 open 1 hr. Rec. 300' muddy

oil 1100# DST 3345-59 open 1 hr.

Rec. 45' ocm 200# DST 3364-98 open 1/2 hr

Rec. 3,100,000 gas 65' ocm 1200#

Simp. 3516 Arb. 3559 DST 3558-61

open 1 hr. Rec. 800' oil TD 3563

5" @ 3558 CO to 3531 59/ 3285-3302

SSO & W 1000 A S/ 11 boph 2500 A

Comp. 77. bopd 40% water

J. G. McGEHEE