


Section 1 Township 22 Range 12W

Well No. 1 Mellies "A"

Company Petroleum Inc. et al

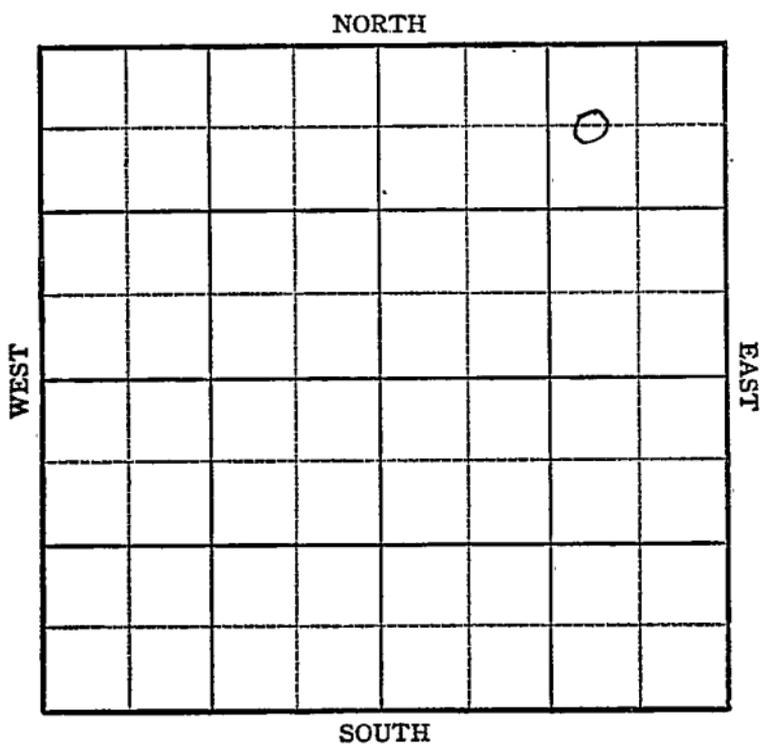

Sec. 1 Twp. 22 R. 12-W

Well No. #1 Mellies "A" Farm

Petroleum Inc. etal Company

Max Pool


660 Ft. from N. Line

_____ Ft. from S. Line

990 Ft. from E. Line

_____ Ft. from W. Line

C W L NE NE

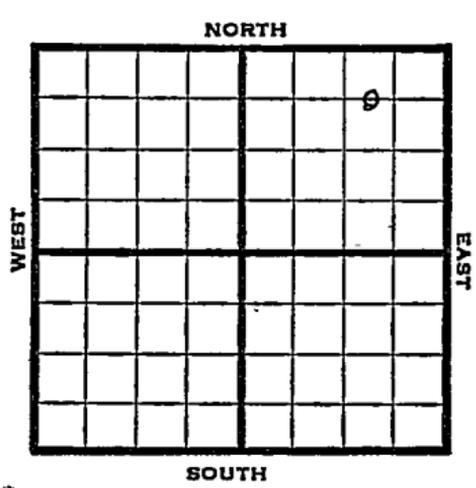

| 1948 | Eli 1803' | REPORT |
|-------|-----------------------------|--------|
| 8/11 | 8" @ 250' | |
| | WOC | |
| 8/18 | Drlg 3050' | |
| 8/25 | Viola 3474 | |
| | Simpson Sand 3546' | |
| | Arbuckle 3549' | |
| | TD 3551 | |
| | 5" @ 3551' | |
| 9/1 | " | |
| 9/8 | TD 3560' | |
| | Swb 50 bbls oil PH - 2 hrs. | |
| | 500 acid | |
| 9/14 | " | |
| 9/21 | " | |
| 9/29 | " | |
| 10/6 | 1000 Acid | |
| 10/13 | " | |
| 10/20 | TD 3600' | |
| | Arb. 3549' | |
| | 5" @ 3551' | |
| | 1500 acid | |
| | Pump 462' oil Pot | |
| | 40° Gr. | |
| | Comp | |
| | COMPLETED | |

OVER

1953
5/6

O. W. P. B.

KC 3201' Viola 3474' Simp. 3496'
Arb. 3549' OTD 3560 5" @ 3551
PB 3313' 24/3279-85 3000 A
S/15 BOPH POP

5/20

Oil Well
TD 3560'
KC 3201, Viola 3474, Simp 3496,
Arb 3549,
OTD 3560
5" @ 3551'
PB 3313 24/ 3279-85 3000 A S/ 15
boph
Comp. 280 bopd.

COMPLETED

Stafford County Kansas State

Map No. _____ Sec. 1 Twp. 22 R. 12W

Well No. -1 Mellies

Petroleum Inc. etal. Company

FIRST REPORT

Contractor

C W L NE NE

SECTION PLAT

| | | | | | | | |
|--|--|--|--|--|--|--|--|
| | | | | | | | |
| | | | | | | | |
660 Ft. from N. Line

_____ Ft. from S. Line

990 Ft. from E. Line

_____ Ft. from W. Line

Max Pool

Remarks:

8" @ 250 WOC

Date AUG 11 1948

Scout S. J. LEWIS

Map No. 46 Sec. 1 Twp. 22 R. 12W

Well No. 1 Mellies

Petroleum Inc. etal. Company

COMPLETE

Contractor

C W L NE NE

E 1, 1903
SECTION PLAT

660 Ft. from N. Line

_____ Ft. from S. Line

990 Ft. from E. Line

_____ Ft. from W. Line

| | | | |
|--|--|--|---|
| | | | 0 |
| | | | |
| | | | |
| | | | |

Stafford County

RECORD

Location _____

Cased _____ in., _____ ft.

Rig up _____

Sand _____

Drilling and Remarks:

Gas _____

Oil

Total Depth 2600

PRODUCTION

1st 24 hrs. Nat. 2.150

1st 24 hrs. after shot _____

Gas _____ Cu. Ft.

Dry Hole _____

Abandoned _____

Art 83549
5" @ 3551
1500 acid
Prng 462 oil Prod
40°/4

Date

OCT 20 1948

19

S. L. LEWIS Scout

O. W. P. B.

County Stafford State KANSAS

Sec. 1 (Blk. 22 (Sur. 12W Map No. (Twp.) (Rge.)

Operator Petroleum Inc.

Well No. 1 Farm Mellies "A"

Elev. 1803 Location C W L NE NE

| | | | | | | | | | |
|--|--|--|--|--|--|--|--|--|--|
| | | | | | | | | | |
| | | | | | | | | | |
660 Ft. From N Line NE

990 Ft. From E Line Quarter

1st. Report

Completion MAY 20 1953

Remarks OWPB

Spudding Date O. W. P. B.

Drlg. Data Oil well TD 3560

KC 3201 Viola 3474 Simp. 3496

Arb. 3549 OTD 3560 5" @ 3551 PB 3313

24/ 3279-85 3000 A S/ 15 boph

Comp. 280 bopd

J. G. MCGEEHEE