

KANSAS


Stafford

Section 1 Township 22 Range 12W

Well No. 3 Mellies "A"

Company Ferrell Drlg et al

Max Pool

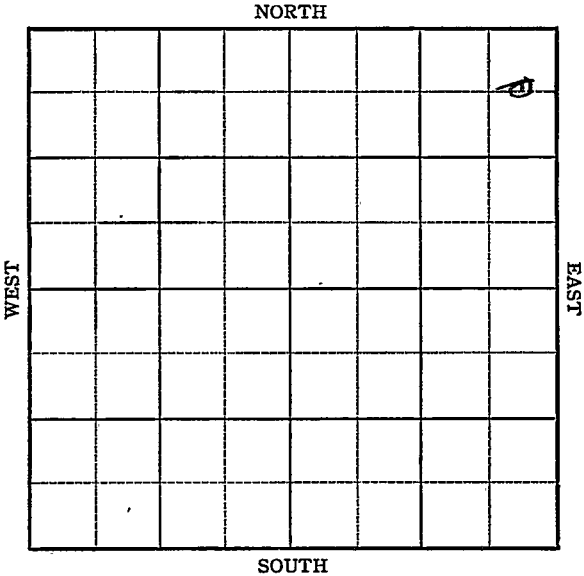

KANSAS

Stafford

Sec. 1 Twp. 22 R. 12W ✓

Well No. #3 Mellies "A" Farm

Ferrell Drlg. etal Company
Max Pool


660' Ft. from N. Line

 Ft. from S. Line

330' Ft. from E. Line

 Ft. from W. Line

C E L NE NE

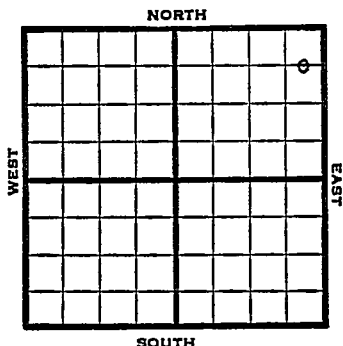

1949

Elev. 1792'

R E P O R T

4/6

8" @ 251'
Drlg. 1300'

4/12

Lansing 3214'
Drlg. 3305'

4/20

Viola 3491' Simpson 3533'
Arbuckle 3577'
TD 3581'
5" @ 3579'

4/27

TD 3585
Acid 500
2 gal oil & 27 gal W PH

5/4

"

5/10

"

5/18

"

5/25

"

6/1

TD 3585'
Lans. 3214'
Arb. 3577'
5"@ 3579'
Perf Lans.
4500 acid
Pump 35 Oil Pot
36° Gr.
Comp

COMPLETED

Kansas

Map No. _____ Sec. 1 Twp. 22 R. 12WWell No. 3 Mellies "A"Ferrell Drlg. etal. Company

FIRST REPORT

Contractor

C E L NE NE

SECTION PLAT

660

Ft. from N. Line

Ft. from S. Line

330

Ft. from E. Line

Ft. from W. Line

Stafford County

			o

Location _____

Rig up _____

Drilling and Remarks:

8" @ 251

drlg. 1300

RECORD

Cased _____ in., _____ ft.

Sand _____

Gas _____

Oil _____

Total Depth _____

PRODUCTION

1st 24 hrs. Nat. _____

1st 24 hrs. after shot _____

Gas _____ Cu. Ft.

Dry Hole _____

Abandoned _____

Date

APR 6 1949 19S. J. LEWIS Scout

Map No. K46 Sec. 1 Twp. 22 R. 12W

Well No. 3 Mellies "A"

Ferrell Drlg. etal.

Company

COMPLETE

Contractor

C E L N E N E

E11792
SECTION PLAT

			d

660 Ft. from N. Line

 Ft. from S. Line

330 Ft. from E. Line

 Ft. from W. Line

Stafford County

Location

Rig up

Drilling and Remarks:

Lane 3214

Ar 43577

5" C3579

*Perf Lane
4500 acs*

*Prod 35 oil bbl
362 lb*

RECORD

Cased in., ft.

Sand

Gas

Oil

Total Depth 3575

PRODUCTION

1st 24 hrs. Nat.

1st 24 hrs. after shot

Gas Cu. Ft.

Dry Hole

Abandoned

Date

JUN 1 1949 19

S. J. LEWIS

Scout