

KANSAS

Stafford


FORM 51 5M 10-41 PETROL

Section 1 Township 22 Range 12-W

Well No. 1 Wolf

Company Stanolind

NORTH **Sittner Pool**

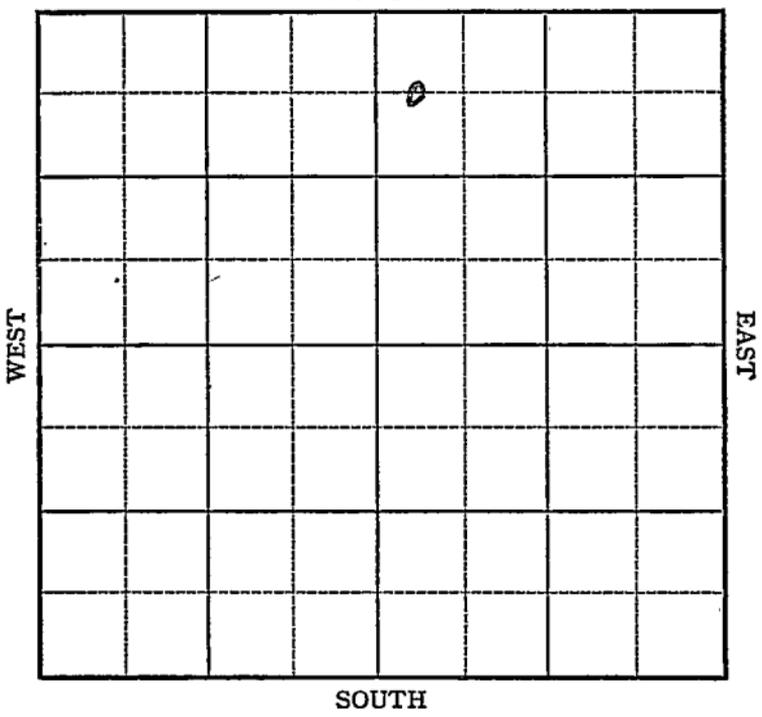



1942

2/25

Lans. 3242'

Arb. 3615'

4" - 3466'

T.D. 3617'

28 shots 3394-99'

49 " 3363-68 $\frac{1}{2}$ '

8500 acid.

Potential 403 bbls., pump.

39.1 Gravity

**COMPLETED**

Stafford

KANSAS

Map No. 46 Sec. 1 Twp. 22 R. 12WWell No. 1 WolfStanolind

Company

**FIRST REPORT**

Contractor

C WL NW NE

660 Ft. from N. Line

\_\_\_\_\_ Ft. from S. Line

330 Ft. from E. Line

\_\_\_\_\_ Ft. from W. Line

## SECTION PLAT

		o	

SITTNER POOL

Location XX

Rig up \_\_\_\_\_

Drilling and Remarks:

## RECORD

Cased \_\_\_\_\_ in., \_\_\_\_\_ ft.

Sand \_\_\_\_\_

Gas \_\_\_\_\_

Oil \_\_\_\_\_

Total Depth \_\_\_\_\_

## PRODUCTION

1st 24 hrs. Nat. \_\_\_\_\_

1st 24 hrs. after shot \_\_\_\_\_

Gas \_\_\_\_\_ Cu. Ft.

Dry Hole \_\_\_\_\_

Abandoned \_\_\_\_\_

Date

JAN 14 1942 19

S. J. LEWIS Scout

Map No. 46 Sec. 1 Twp. 22 R. 12W

Well No. 1 Wolf

Stanolind Company

**COMPLETED**

Contractor

C WL NW NE

SECTION PLAT

660 Ft. from N. Line

		o	

\_\_\_\_\_ Ft. from S. Line

330 Ft. from E. Line

\_\_\_\_\_ Ft. from W. Line

SITTNER POOL

Location \_\_\_\_\_

RECORD

Rig up \_\_\_\_\_

Cased \_\_\_\_\_ in., \_\_\_\_\_ ft.

Drilling and Remarks:

Sand \_\_\_\_\_

*Lease 3242  
Ac 43615*

Gas \_\_\_\_\_

Oil \_\_\_\_\_

*4" @ 3466  
28 shot to 3394-99*

Total Depth 3617

*49 " 3363-68 1/2*

PRODUCTION

*9500 rods*

1st 24 hrs. Nat. \_\_\_\_\_

*Pump 403 P 28*

1st 24 hrs. after shot \_\_\_\_\_

Gas \_\_\_\_\_ Cu. Ft.

Dry Hole \_\_\_\_\_

Abandoned \_\_\_\_\_

*37-32*

Date

FEB 25 1942

S. J. LEWIS

19

Scout