


# KANSAS

Section 1 Township 22 Range 12W

Well No. 2 Mellies "A"  
(Op.) Ferrell Drig Co  
Company Petroleum Inc.

Sittner

NORTH

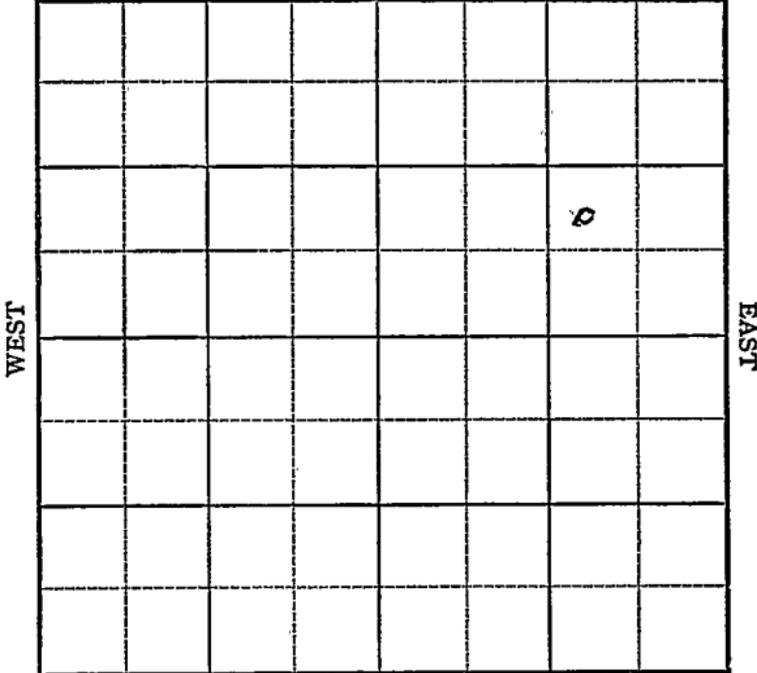

SOUTH

KANSAS

Stafford

Sec. 1 Twp. 22 R. 12W ✓

Well No. #2 Mellies "A" Farm  
Ferrell Drig. + Petal. Inc.  
Petroleum, Inc. Company

Sittner Pool


\_\_\_\_\_ Ft. from N. Line

990' Ft. from S. Line

990' Ft. from E. Line

\_\_\_\_\_ Ft. from W. Line

NW SE NE

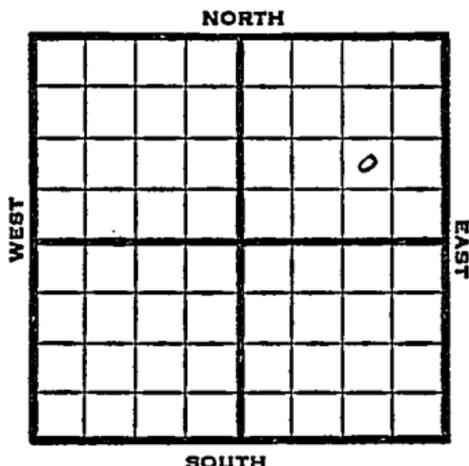

1949

<sup>u</sup>  
Elev 1800' REPORT

3/23

Drig. 3230'

3/30

Lansing 3225'

Viola 3495'

Simpson 3531'

Arbuckle 3589'

TD 3595'

5" @ 3590'

4/6

500 acid

4/12

500 acid

4/20

"

4/27

"

5/4

TD 3595'

Arb. 3589'

5" @ 3590'

1000 acid

Pump 30 Oil Pot

39° Gr.

Comp

**COMPLETED**

Map No. \_\_\_\_\_ Sec. 1 Twp. 22 R. 12W

Well No. 2 Mellies "A"

Petroleum Inc. Company

FIRST REPORT Contractor

NW SE NE

SECTION PLAT

\_\_\_\_\_ Ft. from N. Line

990 Ft. from S. Line

990 Ft. from E. Line

\_\_\_\_\_ Ft. from W. Line

1			0

Stafford County

Location \_\_\_\_\_

Rig up \_\_\_\_\_

Drilling and Remarks:

drlg. 3230

RECORD

Cased \_\_\_\_\_ in., \_\_\_\_\_ ft.

Sand \_\_\_\_\_

Gas \_\_\_\_\_

Oil \_\_\_\_\_

Total Depth \_\_\_\_\_

PRODUCTION

1st 24 hrs. Nat. \_\_\_\_\_

1st 24 hrs. after shot \_\_\_\_\_

Gas \_\_\_\_\_ Cu. Ft.

Dry Hole \_\_\_\_\_

Abandoned \_\_\_\_\_

Date

MAR 23 1949 19

S. J. LEWIS

Scout

Map No. 15 Sec. 1 Twp. 22 R. 12W

Well No. 2 Mellies "A"

Ferrell Drilling & Petroleum Inc. Company

**CORRECTION**

Contractor

NW SE NE

**SECTION PLAT**

\_\_\_\_\_ Ft. from N. Line

990 Ft. from S. Line

990 Ft. from E. Line

\_\_\_\_\_ Ft. from W. Line


Stafford County

Location \_\_\_\_\_

Rig up \_\_\_\_\_

Drilling and Remarks:

Reported  
Petroleum Inc.  
Ferrell will be  
the operator

**RECORD**

Cased \_\_\_\_\_ in., \_\_\_\_\_ ft.

Sand \_\_\_\_\_

Gas \_\_\_\_\_

Oil \_\_\_\_\_

Total Depth \_\_\_\_\_

**PRODUCTION**

1st 24 hrs. Nat. \_\_\_\_\_

1st 24 hrs. after shot \_\_\_\_\_

Gas \_\_\_\_\_ Cu. Ft.

Dry Hole \_\_\_\_\_

Abandoned \_\_\_\_\_

Date

APR 6 1949 19

S. J. LEWIS Scout

