

Finney

KANSAS

SECTION 1 TOWNSHIP 22S RANGE 34W

WELL NO. #1 Warren

COMPANY Panhandle Eastern


NORTH

#

C NW

WEST

EAST

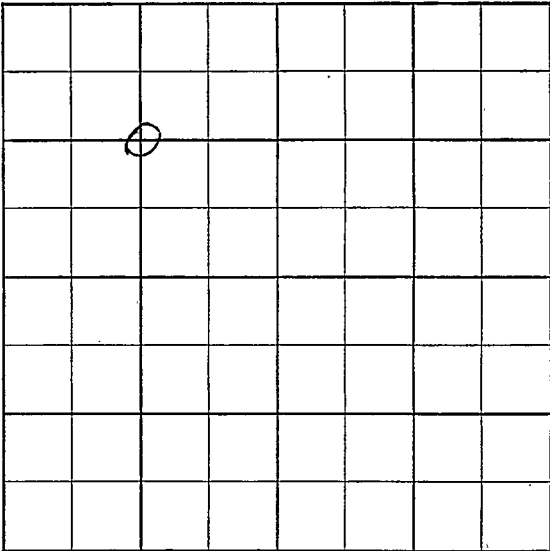

SOUTH

County Finney Elev. _____Sec. 1 Twp. 22 Rge. 34WCompany Panhandle EasternFarm Name Warren No. 1

TOPS	DEPTH	LOG	DATUM
Anh.			
Tp.			
H.			
Tr.			
Dg.			
B.L.			
L.			
K.C.			
B.K.C.			
Ce.			
C.			
M.			
M.			
K.			
Mz.			
Mq.			
V.			
S.			
S.			
A.			
R.			
Pf.			
G.			
T.D.	<u>2650</u>		


Loc. in Sec. _____

C NW

Geol. _____

Contr. _____

Pool _____

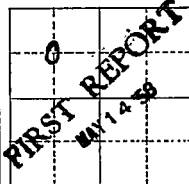HugotonDate Comm. 5-7-587" @ 1498/1504" @ 2645/100

Co.

Lse.

No.

Sec.

T.

R.

~~Top Pool~~
~~Bottom Pool~~

S-513-B

County Finney Elev 2921 OF 2924 RB
Sec. 1 Twp. 22 Rge. 34W
Company Panhandle Western
Farm Name Warren No. 1

TOPS	DEPTH	LOG	DATUM
Anh. <u>Cim</u>	<u>1456</u>		
TP. <u>Herr</u>	<u>2502</u>		
H. <u>Krid</u>	<u>2536</u>		
Tr. <u>Win</u>	<u>2579</u>		
Dg.			
B.L.			
L.			
K.C.			
B.K.C.			
Ce.			
C.			
M.			
M.			
K.			
Mz.			
Mq.			
V.			
S.			
S.			
A.			
R.			
Pf.			
G.			
T.D.	<u>2650</u>		

Loc. in Sec. C NW

Geol.
Contr.

Pool Hugoton

COMPLETE

SEP 10 '58

Date Comm. 5-7-58
7" @ 498/150 4" @ 2645/100 MAY 21 '58
40/2542-57 1/2 ga 350 mcf
dry .72/2529-47 20/2519-24
3 ga 736 mcf + Ld + sty MAY 28 '58
Free 20x10 ga 3.140 mcf 18 hrs
kn Tbg wpc JUN 3 '58 JUN 11 '58 JUN 18 '58 JUN 25 '58
JUL 2 '58 JUL 9 '58 JUL 16 '58 JUL 23 '58 JUL 30 '58
AUG 6 '58 AUG 13 '58 AUG 20 '58 AUG 27 '58 SEP 3 '58
SEP 10 '58
State deliver 1,233 MCF RP 417