

Kearny


KANSAS

DX 78-1

Section 1 Township 22 Range 35W

Well No. #5 Rooney

Company Kansas-Nebraska.

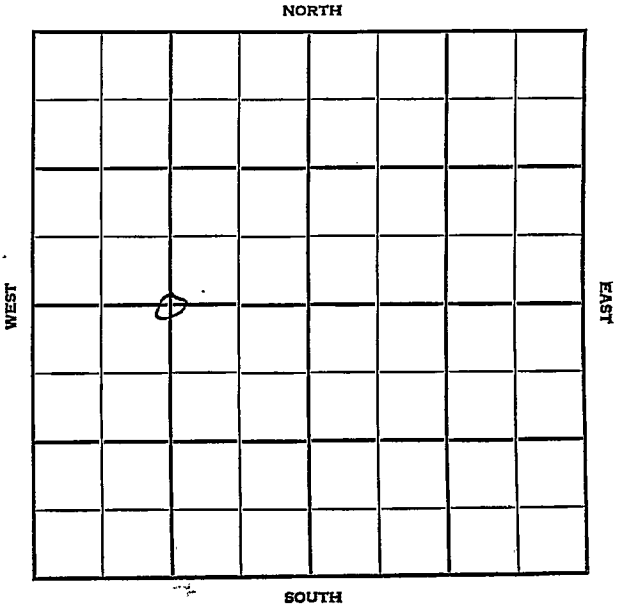

Kearny

~~KANSAS~~

SEC. 1	TWP. 22	R. 35W
------------------	-------------------	------------------

WELL NO. **#5 Rooney** FARM

COMPANY **Kansas-Nebraska.**

CONTRACTOR **Honaker Drlg.**

Hugoton Pool

2640	Ft. from N. Line	<div style="display: flex; align-items: center; justify-content: center;"> <div style="writing-mode: vertical-rl; transform: rotate(180deg); font-size: small;">WEST</div> <table border="1" style="border-collapse: collapse; text-align: center;"> <tr><td colspan="6">NORTH</td></tr> <tr><td> </td><td> </td><td> </td><td> </td><td> </td><td> </td></tr> <tr><td> </td><td> </td><td> </td><td> </td><td> </td><td> </td></tr> <tr><td> </td><td> </td><td> </td><td> </td><td> </td><td> </td></tr> <tr><td> </td><td> </td><td> </td><td> </td><td> </td><td> </td></tr> <tr><td> </td><td> </td><td> </td><td> </td><td> </td><td> </td></tr> <tr><td> </td><td> </td><td> </td><td> </td><td> </td><td> </td></tr> <tr><td> </td><td> </td><td> </td><td> </td><td> </td><td> </td></tr> <tr><td colspan="6">SOUTH</td></tr> </table> <div style="writing-mode: vertical-rl; font-size: small;">EAST</div> </div>	NORTH																																																SOUTH					
NORTH	
SOUTH	
	Ft. from S. Line	
	Ft. from E. Line	
1320	Ft. from W. Line	

C W $\frac{1}{2}$ Sec.

1955	ELEVATION 3030'	REPORT
------	---------------------------	--------

4/13	Spud 4-7-55 10" @ 296' Drlg. 2325'
5/25	Herr 2590; Kri 2610; Winf 2650; TD 2689; 10" 296; log; 5 $\frac{1}{2}$ " 2688; 180/2593-2623; 108/2652-70; frac; 1,832,000 cfg plus 25 gwph; 1,832,000 cfg plus 25 gfph from Kri & Winf.

COMPLETED

