

# KANSAS

Stafford

Section 10 Township 22 Range 13W

Well No. 1 Hahn

Company Ferrell Drlg et al  
Wildcat

NORTH

0							

WEST

EAST

SOUTH

KANSAS

Stafford

Sec. 10 Twp. 22 R. 13W

Well No. #1 Hahn Farm

Ferrell Drlg. et al Company


(Ferrell Drlg., Cont.)

330' Wildcat  
Ft. from N. Line

\_\_\_\_\_ Ft. from S. Line

\_\_\_\_\_ Ft. from E. Line

330' Ft. from W. Line

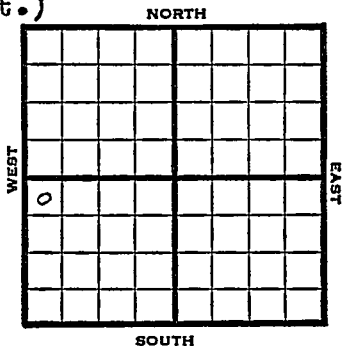

NW SW

1949

Elev <sup>1897</sup> 1897' REPORT

5/11

Location

5/18

8" @ 305'  
Drlg 2570'

5/25

Lansing 3881' ✓  
Viola 3681'  
Simpson 3721'  
Arbuckle 3773'  
TD 3376'  
5" @ 3774'

6/1

"

6/1

"

6/15

TD 3786'  
500 acid  
Swb 15 bbls oil PH - 8 hrs.

6/21

"

6/28

"

7/6

"

7/12

"

7/20

"

7/27

"

8/3

TD 3786'  
Arb. 3773'  
5" @ 3774'  
500 acid  
Pump 408 Oil / 2% W Pot  
30° Gr1  
Comp

COMPLETED

Kansas

Map No. \_\_\_\_\_ Sec. 10 Twp. 22 R. 13W

Well No. 1 Hahn

Ferrell Drlg. etal. Company

Ferrell Drlg. Contractor

NW SW

FIRST REPORT  
SECTION PLAT

330 Ft. from N. Line

\_\_\_\_\_ Ft. from S. Line

\_\_\_\_\_ Ft. from E. Line

330 Ft. from W. Line

△			

Stafford County

Location X

Rig up \_\_\_\_\_

Drilling and Remarks:

## RECORD

Cased \_\_\_\_\_ in., \_\_\_\_\_ ft.

Sand \_\_\_\_\_

Gas \_\_\_\_\_

Oil \_\_\_\_\_

Total Depth \_\_\_\_\_

## PRODUCTION

1st 24 hrs. Nat. \_\_\_\_\_

1st 24 hrs. after shot \_\_\_\_\_

Gas \_\_\_\_\_ Cu. Ft.

Dry Hole \_\_\_\_\_

Abandoned \_\_\_\_\_

Date

MAY 11 1949

19

S. J. LEWIS Scout

Kansas

Wildcat

Map No. K 82 Sec. 10 Twp. 22 R. 13W

Well No. 1 Hahn

Ferrell Drlg. etal. Company

**COMPLETE**

Contractor

NW SW

*E11897*

SECTION PLAT

330 Ft. from N. Line

         Ft. from S. Line

         Ft. from E. Line

330 Ft. from W. Line

o			

Stafford County

Location \_\_\_\_\_

Rig up \_\_\_\_\_

Drilling and Remarks:

*Ca 83773*  
*5" @ 3774*  
*500 acal*  
*Prod 40 oil + 270*  
*Pa X*

**RECORD**

Cased \_\_\_\_\_ in., \_\_\_\_\_ ft.

Sand \_\_\_\_\_

Gas \_\_\_\_\_

Oil \_\_\_\_\_

Total Depth *3774*

**PRODUCTION**

1st 24 hrs. Nat. \_\_\_\_\_

1st 24 hrs. after shot \_\_\_\_\_

Gas \_\_\_\_\_ Cu. Ft.

Dry Hole: \_\_\_\_\_

Abandoned: \_\_\_\_\_

Date

AUG 3 1949 19

S. J. LEWIS Scout