


Section 10 Township 22 Range 13 W

Well No. # 1 Hahn

Company Petroleum Inc.

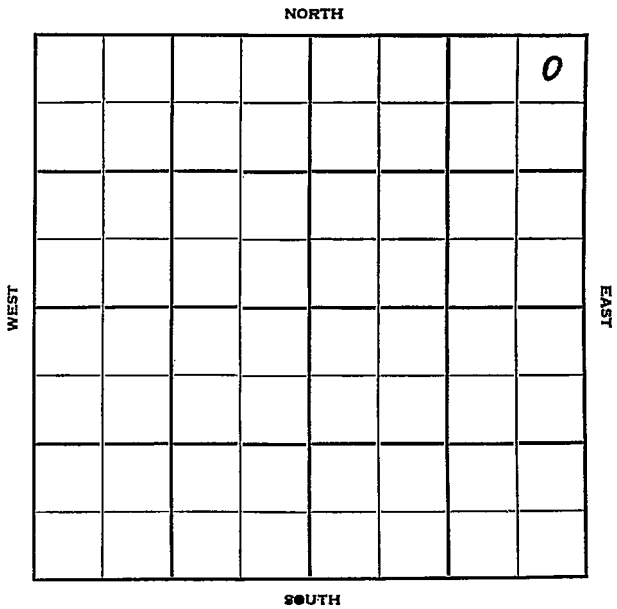

Sec. 10 Twp. 22 R. 13W

Well No. #1 Hahn Farm

Petroleum Inc. Company

Garvey Contractor


330 Ft. from N. Line

_____ Ft. from S. Line

330 Ft. from E. Line

_____ Ft. from W. Line

NE NE NE

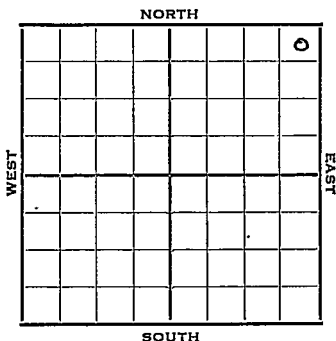

1952

Elev. 1885' REPORT

7/30

Spud 7-26-52
8" @ 239'
Drlg. 1675'

8/6

Anhy 730 Heeb. 3221
Tor. 3240 Br Li 3348
Lans. 3367 -
DST 3498-3557 1 hr; 30' M 130#
Drlg. 3672

8/13

Spud 7-26-52 D&A TD 3738
8" @ 239 Anhy 730 Heeb. 3221
Tor. 3240 Br Lime 3348
Lans. 3367
DST 3498-3557 opn 1 hr. Rec. 30' mud
130# Cong. 3635 Viola 3639
Simp 3680 DST 3617-84 opn 1 hr.
Rec. 30' mud 0# DST 3658-3710 opn
3/4 hr. Rec. 23' mud 42#
Arb. 3733 DST 3734-38 opn 1 hr.
Rec. 30' mud & wtr 40' wtr 1010#
D&A

ABANDONED

