

FORM 51 25M 3-49 PETROL

KANSAS

Section 10 Township 22 Range 12 -W

Well No. #3 Ahnert

Company Stanolind

NORTH

WEST

EAST

							0

SOUTH

KANSAS

Stafford

Sec. 10 Twp. 22 R. 12-W

Well No. #3 Ahnert Farm

Stanolind Company

Max Contractor


330 Ft. from N. Line

 Ft. from S. Line

330 Ft. from E. Line

 Ft. from W. Line

NE NE NE

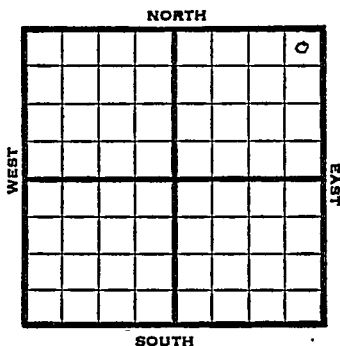

1950 Elev 1846 REPORT

6/7 Spud 6-4-50
Anhy 634
8 5/8" @ 645

6/28 Anhy 634
8 5/8" @ 645
Lans 3293 Arb 3662
DST 3644-66 opn 2 hr rec 15' mud
DST 3666-71 opn 1hr rec 35' mud
DST 3671-76 opn 2 hrs rec 35' mud
DST 3676-81 opn 1 hr rec 60' muddy wtr
D&A

ABANDONED

Map No. _____ Sec. 10 Twp. 22 R. 12WWell No. 3 AhnertStanolind _____ Company_____ Contractor
NE NE NE E1.1846**SECTION PLAT**330 _____ Ft. from N. Line

_____ Ft. from S. Line

330 _____ Ft. from E. Line

_____ Ft. from W. Line

Stafford

			0
FIRST		REPORT	

Location _____

Rig up _____

Drilling and Remarks:

Spud 6-4-50

Anhy. 634

8 5/8 @ 645

RECORD

Cased _____ in., _____ ft.

Sand _____

Gas _____

Oil _____

Total Depth _____

PRODUCTION

1st 24 hrs. Nat. _____

1st 24 hrs. after shot _____

Gas _____ Cu. Ft.

Dry Hole _____

Abandoned _____

Date

JUN 7 1959J. E. TYRA Scout

Kansas

Map No. _____ Sec. 10 Twp. 22 R. 12WWell No. 3 Ahnert

Stanolind _____ Company

Contractor _____

NE NE NE


El. 1846
SECTION PLAT330 Ft. from N. Line

_____ Ft. from S. Line

330 Ft. from E. Line

_____ Ft. from W. Line

Stafford County

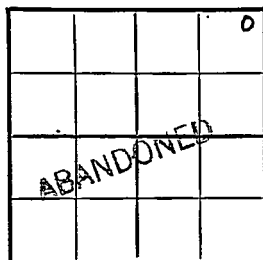

Location _____

Rig up _____

Drilling and Remarks:

Anh $\ddot{y}$ 634

8 5/8" C 645

Lans. 3293

Arb: 3662

DST 3664-66

open 2 hr.

Rec: 15' mud

RECORD

Cased _____ in., _____ ft.

Sand _____

Gas _____

Oil _____

Total Depth 3681

PRODUCTION

1st 24 hrs. Nat. _____

1st 24 hrs. after shot _____

Gas _____ Cu. Ft.

Dry Hole _____

Abandoned _____

Date

JUN 28 1950J. E. TYRA Scout

DST 3666-71

open 1 hr.

Rec. 35' mud

DST 3671-76

open 2 hr.

Rec. 35' mud

DST 3676-81

open 1 hr

Rec. 60' muddy water

D. & A

Misc.
Pierce Map
France Map
Tracings
Land Wall Map
Land Small Map
Scout Cards

July

Aug

Sept

Oct

Nov

Dec

Jan

Feb

Mar

Apr

May