


Section 10 Township 22 Range 12W

Well No. #2 Ahnert

Company Stanolind

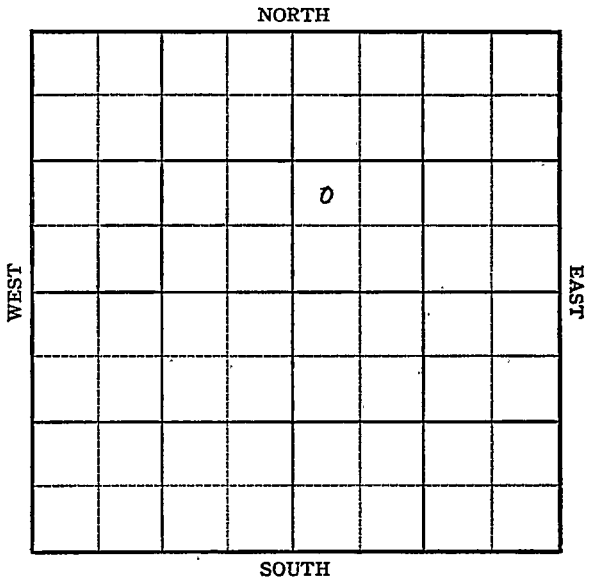


Sec. 10 Twp. 22 R12W

Well No. #2 Ahnert Farm

Stanolind Company

Max Pool (Noble, Contr.)

NORTH

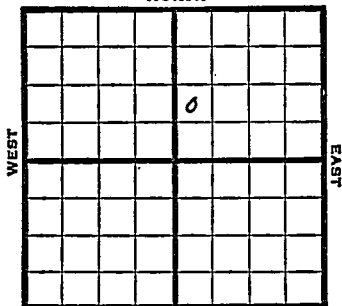

\_\_\_\_\_ Ft. from N. Line

990' Ft. from S. Line

\_\_\_\_\_ Ft. from E. Line

330' Ft. from W. Line

NW SW NE

SOUTH

1949

REPORT

12/14 Anhy 642'  
 8 @ 548'  
 Drlg. 2400'

1950  
 1/4

TD 3665'  
 Anhy 642'  
 8" @ 648'  
 Heeb 3149'  
 Lans 3301'  
 Cong 3542'  
 Viola 3554'  
 Simp 3603'  
 Arb 3661'  
 DST 3661-65'  
 120' oil & gas cut mud  
 5" @ 3662'  
 500 acid  
 Pump 100 oil  
 No wtr.  
 Comp

**COMPLETED**

Kansas

Max Pool

Map No. \_\_\_\_\_ Sec. 10 Twp. 22 R. 12W

Well No. 2 Ahnert

Stanolind

Company

Noble

Contractor

NW SW NE

FIRST REPORT  
SECTION PLAT

\_\_\_\_\_ Ft. from N. Line

990 Ft. from S. Line

\_\_\_\_\_ Ft. from E. Line

330 Ft. from W. Line

		o	

Stafford County

Location \_\_\_\_\_

Rig up \_\_\_\_\_

Drilling and Remarks:

Anhy 642

8" @ 648

drlg 2400

## RECORD

Cased \_\_\_\_\_ in., \_\_\_\_\_ ft.

Sand \_\_\_\_\_

Gas \_\_\_\_\_

Oil \_\_\_\_\_

Total Depth \_\_\_\_\_

## PRODUCTION

1st 24 hrs. Nat. \_\_\_\_\_

1st 24 hrs. after shot \_\_\_\_\_

Gas \_\_\_\_\_ Cu. Ft.

Dry Hole \_\_\_\_\_

Abandoned \_\_\_\_\_

Date

DEC 14 1949

19

S. I. LEWIS

Scout

Map No. \_\_\_\_\_ Sec. 10 Twp. 22 R. 12W

Well No. 2 Ahnert

Stanolind Company

Contractor

NW SW NE

SECTION PLAT

		0	
		COMPLETE	

\_\_\_\_\_ Ft. from N. Line

990 Ft. from S. Line

\_\_\_\_\_ Ft. from E. Line

330 Ft. from W. Line

Stafford County

RECORD

Location \_\_\_\_\_

Cased \_\_\_\_\_ in., \_\_\_\_\_ ft.

Rig up \_\_\_\_\_

Sand \_\_\_\_\_

Drilling and Remarks:

Gas \_\_\_\_\_

*Anhy* 642

Oil \_\_\_\_\_

*8" @* 648

Total Depth 3665

*Heel.* 3149

*Rans.* 3301

*Comp.* 3542

*Vial* 3554

*Simp.* 3603

*arb.* 3661

*DST* 3661-65

*120' oil + gas cut mud*

PRODUCTION

1st 24 hrs. Nat. \_\_\_\_\_

1st 24 hrs. after shot \_\_\_\_\_

Gas \_\_\_\_\_ Cu. Ft.

Dry Hole \_\_\_\_\_

Abandoned \_\_\_\_\_

*5" @* 3662

Date *500 acid Pump 120' oil no water*

*JAN 4 1950*

19

*J. E. Lynn* Scout