


KANSAS - Stafford

Section 10 . Township 22 Range 12W

Well No. 1 Spangenberg

Company Petroleum Inc.

Brock
NORTH

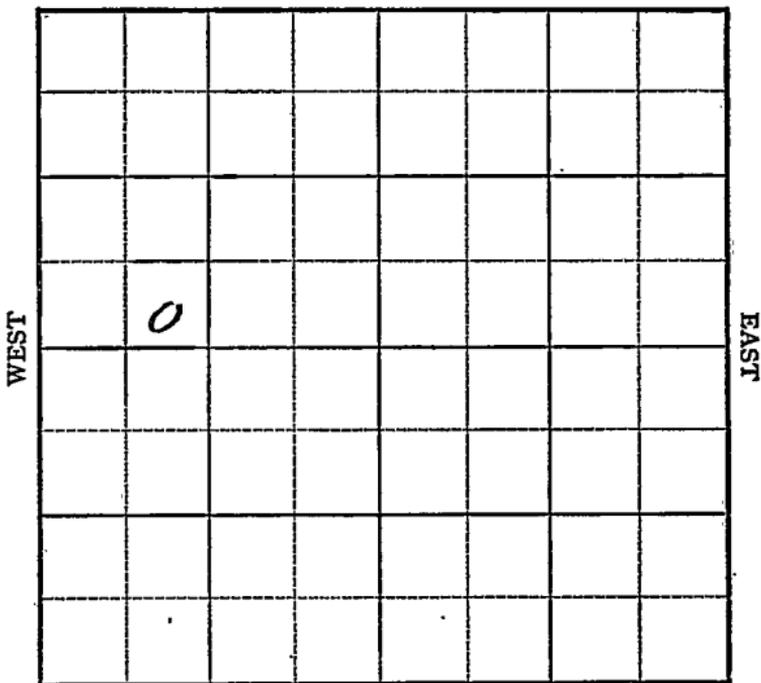

SOUTH

Sec. 10 Twp. 22 R. 12W ✓

Well No. #1 Spangenberg Farm

Petroelum, Inc. Company

Brock Pool

_____ Ft. from N. Line


330'

_____ Ft. from S. Line

_____ Ft. from E. Line

990' Ft. from W. Line

SE SW NW

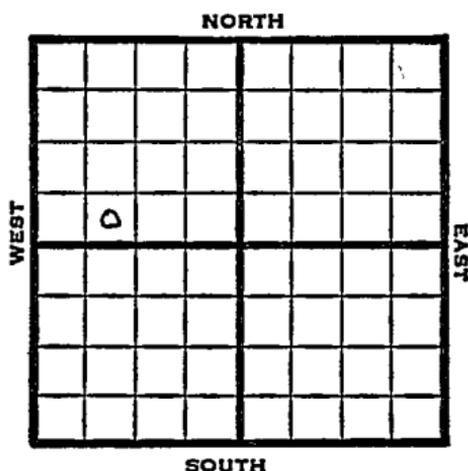

1949

Elev 1860' REPORT

- 3/30 Location
- 4/6 8" @ 245'
Drlg. 2100'
- 4/12 Lansing 3398'
Drlg. 3487'
- 4/20 Viola 3543'
Arbuckle 3643'
TD 3646'
5" @ 3644'
- 4/27 Swb 15 bbls oil PH
- 5/4 "
- 5/10 "
- 5/18 500 acid
- 5/25 TD 3646'
Arb. 3643'
5" @ 3644'
500 acid
Echo Pot 2900' oil
39° Gr.
Gomp

COMPLETED

Map No. _____ Sec. 10 Twp. 22 R. 12W

Well No. 1 Spangenberg

Petroleum Inc. Company

FIRST REPORT Contractor

SE SW NW

SECTION PLAT

_____ Ft. from N. Line

330 Ft. from S. Line

_____ Ft. from E. Line

990 Ft. from W. Line

Stafford County

RECORD

Location X

Cased _____ in., _____ ft.

Rig up _____

Sand _____

Drilling and Remarks:

Gas _____

Oil _____

Total Depth _____

PRODUCTION

1st 24 hrs. Nat. _____

1st 24 hrs. after shot _____

Gas _____ Cu. Ft.

Dry Hole _____

Abandoned _____

Date

MAR 30 1949

19

S. J. LEWIS

Scout

