


Section 10 Township 22 Range 12W

Well No. #8 Spangenberg

Company Petroleum Inc.

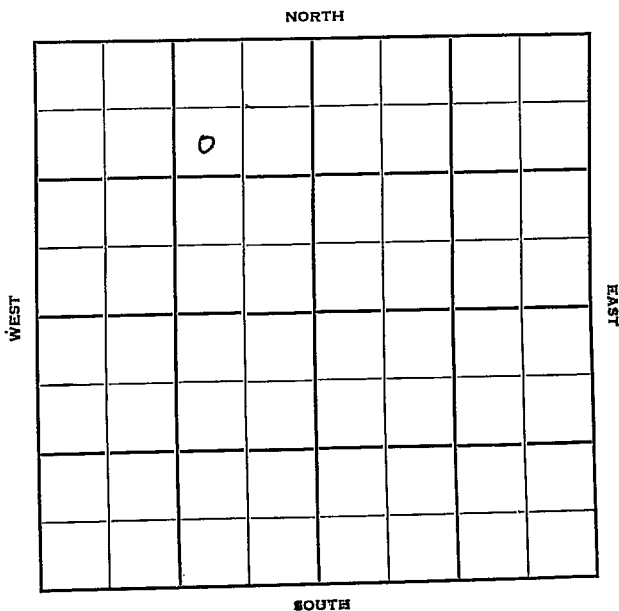

Sec. 10 Twp. 22 R. 1

Well No. #8 Spangenberg Farm

Petroleum Inc. Company

Garvey Contractor


Max 990 Ft. from N. Line

Ft. from S. Line

990 Ft. from E. Line

Ft. from W. Line

SW NE NW

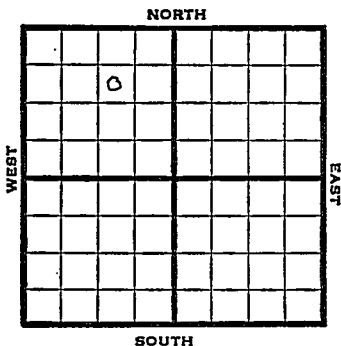

1950 Elev. 1857' REPORT

7/26 Spud 7-23-50
8" @ 195
drlg 300

9/13 Spud 7-23-50
Oil Well TD 3710'
8" @ 195'
Br. Lime 3283' Lans. 3301'
BKC 3522' Heeb 3150'
Toronto 3169'
DST 3328-50 opn 35 min. Rec. 12' OCM
DST 3426-41 opn 17 min. Rec. 25' mud
DST 3465-79 opn 30 min. Rec. 6' OCM
Viola 3551' Simp. 3604' Arb. 3660'
DST 3661-64 opn 35 min.
Rec. 100' clean gassy oil 5" @ 3709'
TD 3710'
3/3660-61 8 goph 250 A
S/4-3/4 BOPH Comp. 34 BOPD 3% wtr.

COMPLETED

Map No. _____ Sec. 10 Twp. 22 R. 12WWell No. 8 Spangenberg_____ Petroleum Inc. _____ Company_____ Garvey _____ Contractor

SW NE NW

_____ 990 Ft. from N. Line

_____ Ft. from S. Line

_____ 990 Ft. from E. Line

_____ Ft. from W. Line

SECTION PLAT

	0		
FIRST REPORT			

Stafford County

Location _____

Rig up _____

Drilling and Remarks:

Spud 7-23-50

8" @ 195

drlg. 300

RECORD

Cased _____ in., _____ ft.

Sand _____

Gas _____

Oil _____

Total Depth _____

PRODUCTION

1st 24 hrs. Nat. _____

1st 24 hrs. after shot _____

Gas _____ Cu. Ft.

Dry Hole _____

Abandoned _____

Date

JUL 26 1950 19J. E. TYRA Scout

County Stafford State Kansas

Sec. 10 (Blk. 22) (Sur. 12W) Map No.

Operator Petroleum Inc.

Well No. 8 Farm Spangenberg

Elev. 1857 Location SW NE NW

	0				
COMPLETE					

990 Ft. From N Line NW

990 Ft. From E Line Quarter

Ist. Report

Completion SEP 13 1950

Remarks

Max Pool

Spudding Date 7-23-50

Drig. Data Oil well TD 3710

8" @ 195 Br. lime 3283 Lans. 3301

B KC 3522 Heeb. 3150 Toronto 3169

DST 3328-50 open 35 min. Rec. 12' ocm

DST 3426-41 open 17 min. Rec. 25' mud

DST 3465-79 open 30 min. Rec. 6' ocm

Viola 3551 Simp. 3604 Arb. 3660'

DST 3661-64 open 35 min. Rec. 100' clean

gassy oil 180' gassy oil 5" @ 3709

TD 3710 3/ 3660-61 8 goph 250 A

S/ 4 3/4 boph Comp. 34 bopd 3% water