


KANSAS

Stafford

Section 10 Township 22 Range 12-W

Well No. #2 K Teichmann "A"

Company Stanolind

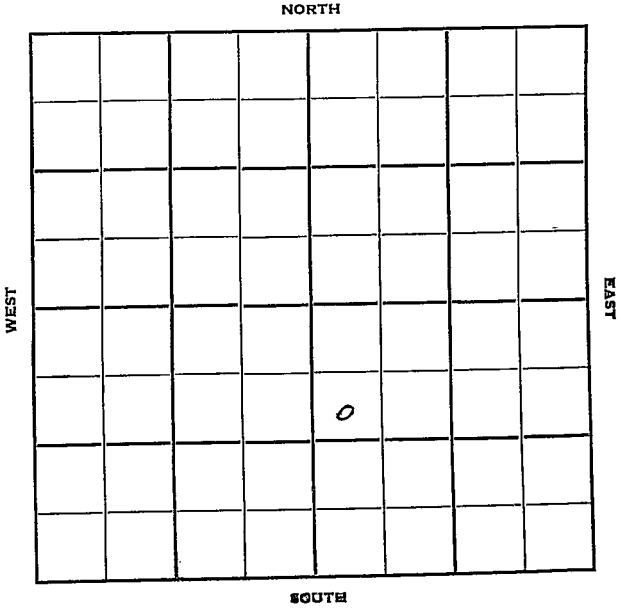

Stafford KANSAS

Sec. 10 Twp. 22 R. 12W

Well No. #2 K. Teichmann "A" Farm

Stanolind Company

Contractor

Sittner Pool


660' Ft. from N. Line

Ft. from S. Line

Ft. from E. Line

330' Ft. from W. Line

C W L NW SE

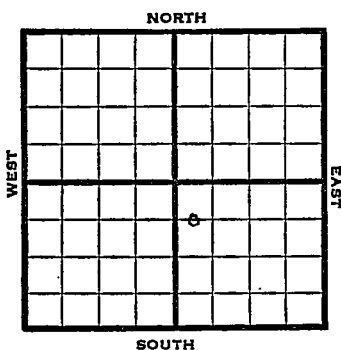

1950 Elev. 1852' REPORT

2/22 Location

3/29 TD 3656'
8 5/8" @ 644'
5" @ 3651'
Lans 3292'
Arb. 3651'
225 BOPD
Comp

COMPLETED

Map No. _____ Sec. 10 Twp. 22 R. 12WWell No. 2 K. Teichmann "A"

Stanolind

Company

Contractor

C W L NW SE


El. 1852

SECTION PLAT

660 Ft. from N. Line

_____ Ft. from S. Line

_____ Ft. from E. Line

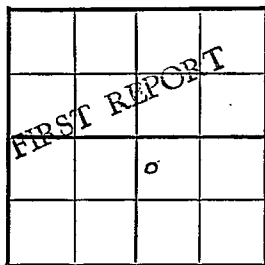330 Ft. from W. Line

Stafford County

Location X

Rig up _____

Drilling and Remarks:

RECORD

Cased _____ in., _____ ft.

Sand _____

Gas _____

Oil _____

Total Depth _____

PRODUCTION

1st 24 hrs. Nat. _____

1st 24 hrs. after shot _____

Gas _____ Cu. Ft.

Dry Hole _____

Abandoned _____

Date

FEB 22 1950

19

J. E. TYRA

Scout

Kansas

Max Sittner Pool

Map No. _____ Sec. 10 Twp. 22 R. 12WWell No. 2 K. Teichmann "A"

Stanolidd

Company

C W L NW SE

Contractor


E. 1852

SECTION PLAT

660 Ft. from N. Line

_____ Ft. from S. Line

_____ Ft. from E. Line

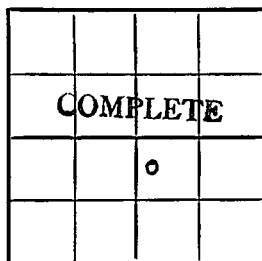330 Ft. from W. Line

Stafford County

Location _____

Rig up _____

Drilling and Remarks:

*8 5/8" @ 644**5" @ 3651**Loss 3292**and 3651**225 BOPD*

RECORD

Cased _____ in., _____ ft.

Sand _____

Gas _____

Oil _____

Total Depth 3656

PRODUCTION

1st 24 hrs. Nat. _____

1st 24 hrs. after shot _____

Gas _____ Cu. Ft.

Dry Hole _____

Abandoned _____

Date

MAR 29 1950

19

J. E. TYRA Scout