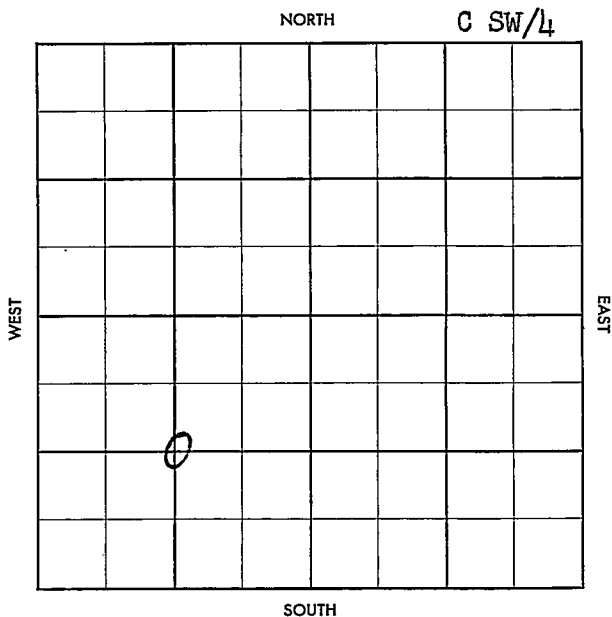


SECTION 10 TOWNSHIP 22 RANGE 32WWELL NO. #1 Anna Miller Gas UnitCOMPANY ~~##~~ Texas & Sinclair

35

FORM 513 SUNRAY

County Hinney Elev. _____
Sec. 10 Twp. 22 Rge. 32W
Company Texas & Sinclair
Farm Name Anna Miller Gas Unit No. 1

TOPS	DEPTH	LOG	DATUM
Anh.			
TP.			
H.			
Tr.			
Dg.			
Bl.			
L.			
K.C.			
B.K.C.			
Ce.			
C.			
M.			
M.			
K.			
Mz.			
Mq.			
V.			
S.			
S.			
A.			
R.			
PE.			
G.			
T.D.			

Loc. in Sec. _____
C SW/4
Geol. _____
Contr. _____
Pool _____

FIRST REPORT
SEP 11 1957

Date Comm. _____
Location _____

Co.
Lse.
No.
Sec.
T.
R.

County Finney Elev. 2938 0P
 Sec. 10 Twp. 22 Rge. 32W
 Company Texas & Sinclair
 Farm Name Anna Miller Gas Unit No. 1

TOPS	DEPTH	LOG	DATUM	Loc. in Sec.
Anb.				
TP.				
H.				
Tr.				
Dg.				
Bl. <u>Hess</u>		<u>2640</u>		
L. <u>U 15F1</u>		<u>2672</u>		
K.C. <u>"</u>		<u>2689</u>		Geol.
B.K. <u>W in</u>		<u>2727</u>		Contr.
Ce.				
C.				
M.				
M.				Pool
K.				
Mz.				
Ma.				
V.				
S.				
S.				
A.				
R.				
PE.				
G.				
T.D.	<u>-749</u>			

COMPLETE
 NOV 6 '57

Date Comm.

Location 8 1/2 32 36 1/4 37Jct. 10-10-57 85 519/350on log 5 1/2" 2749/700 woc57 CB 2740 16/2728-32500A frac 2.800 mcpS SPHY " BL P 271624/2674-80 ga 52m CF maxfrac 3x3 ga 1.802 mcpCO 2740 ga 3.758 mcp

FORM 513-1 SUNRAY

+ 1d 51 72-20 1.1.0.30

72-20 8.865 MFC ~~AE~~ str. water

SIP 418

10-22-32W

Cm:1/4