


Finney

KANSAS

SECTION 10 TOWNSHIP 22 RANGE 33WWELL NO. #1 BeckerCOMPANY Northern Pump

NORTH

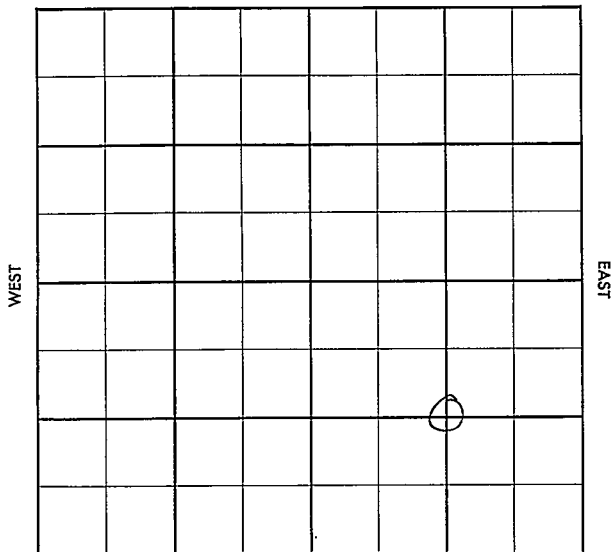

SOUTH

Finney

KANSAS

SEC.	TWP.	R.
10	22	33W

WELL NO.

#1 Becker

FARM

COMPANY

Northern Pump

CONTRACTOR

Garvey

Hugoton


_____ Ft. from N. Line

_____ Ft. from S. Line

_____ Ft. from E. Line

_____ Ft. from W. Line

C SE/ 4

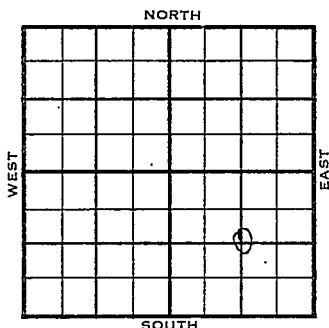

1956	ELEVATION	REPORT
	2878	

3-24-56
 3-28 10" @ 313 w/250
 WOC
 6-13 7" @ 2681 w/750
 CO to 2680
 34/ 2652-60 2000A
 425 mcfg 1250 A PB 2645
 32/ 2600-08, 3 2/2620-28
 Frac 1,332 mcfg, 35 gwph
 CO to 3675 4/ 2640-41 100A
 CO to 2627 25// 2605-10
 20/ 2620-24 250 A 1000A
 100 mcfg 1000 A. 320 mcfg
 inc. to 900 mcfg. 452 mcfg. 400A
 1500 A
 Comp. SI gas well 11,403 mcfgpd
 Log:
 Herr 2601', Kri 2615', Wfd. 2649'

COMPLETED

County

~~Finney~~

Elev.

Sec.

10

Twp.

22

Rge.

33W

Company

~~Northern Pump~~

FarmName

~~Becker~~

No.

1

TOPS

DEPTH

LOG

DATUM

Loc. in Sec.

Anh.

Tp.

H.

Tr.

Dg.

Bl.

L.

K.C.

B.K.C.

Ce.

C.

M.

M.

K.

Mz.

Mo.

V.

S.

S.

A.

R.

P.E.

G.

T.D.

C SE/11

Geol.

Contr.

Garvey

Pool

Hugoton

FIRST REPORT

MAR 28 '56

Date Comm.

10" @ 313/250 WOC

Co.

Lse.

No.

Sec.

T.

R.

County Finney Elev. 2878
 Sec. 10 Twp. 22 Rge. 33W
 Company Northern Pump
 Farm Name Becker No. 1

TOPS	DEPTH	LOG	DATUM	Loc. in Sec.
Anh.				C SE/4
Tp.				
H. <u>Nerr.</u>		<u>2601</u>		
Tr. <u>Rw</u>		<u>2645</u>		
Dg. <u>Wfdr</u>		<u>2649</u>		
BL.				
L.				
K.C.				Geol.
B.K.C.				Contr.
Ce.				<u>Garvey</u>
C.				Pool
M.				<u>Hugoton</u>
M.				
K.				
Mz.				
Ma.				
V.				
S.				
S.				
A.				
R.				
PE.				
G.				
T.D.				

COMPLETE

JUN 13 56

Date Comm. 3-24-56

10" @ 313/250 7" @ 2681/750

CO to 2680 34/ 2652-60 2000 A

425 mcfg 1250 A PB 2645 32/ 2600-08

3 2/ 2620-28 frac 1,332 mcfg

35 gwph CO to 2675 4/ 2640-41

100 A CO to 2627 25/ 2605-10

20/ 2620-24 250 A 1000 A

100 mcfg 1000 A 302 mcfg

OVER

inc. to 900 mcfg 452 mcfg 400 A
1500 A Comp. SI gas well 1,403 mcfgpd

JUN 25 1956