


DX 78-1

Section 10 Township 22 Range 34W

Well No. #1 Miller

Company Pet. Inc. Kansas-Nebraska & Shallow Wtr
Ref.

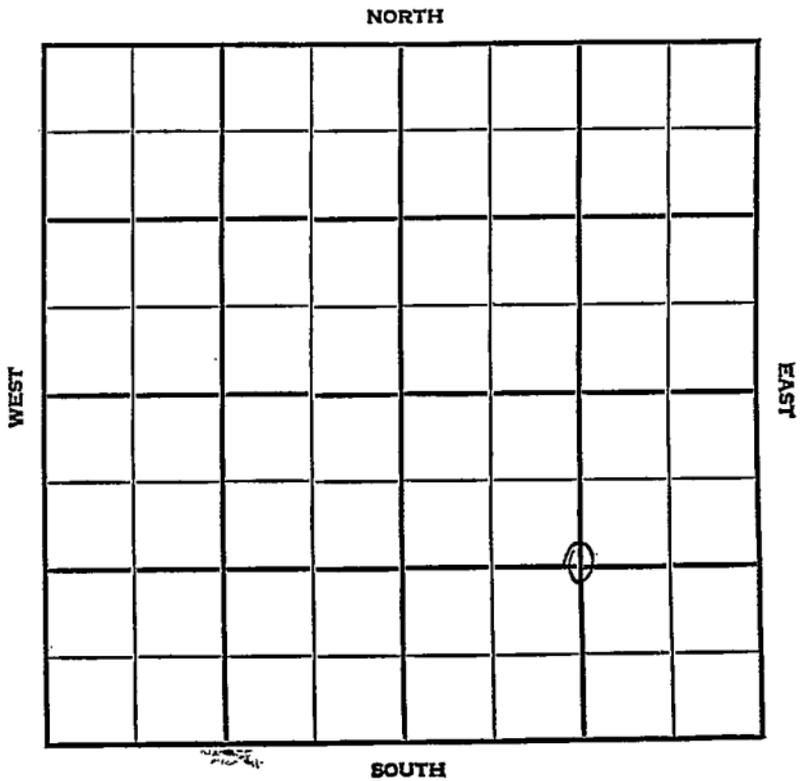

Finney

KANSAS

SEC.	TWP.	R.
10	22	34 W

WELL NO.

1 Miller

FARM

COMPANY

Pet. Inc. Kansas-Nebraska & Shallow
Water Ref.

CONTRACTOR

Garvey

Hugoton Pool


_____ Ft. from N. Line

1320 _____ Ft. from S. Line

1320 _____ Ft. from E. Line

_____ Ft. from W. Line

C SE/4

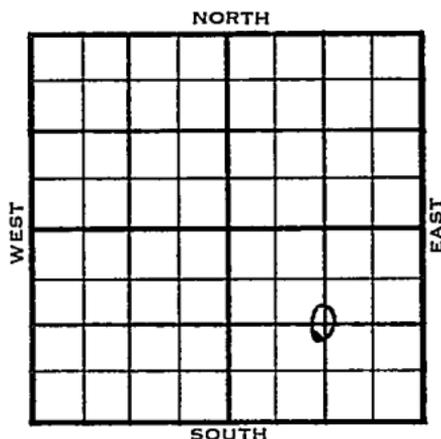

1955

ELEVATION

2943' - 2938'

REPORT

1/12

Spud 1-5-55
 8" @ 285' er. 2555 Kri. 2563
 B. Kri. 2586 Win. 2604'
 TD 2613'

3/9


Spud 1-5-55 - Gas Well
 TD 2613'
 8" @ 285'
 Her. 2555', Kri 2563', B Kri 2586',
 Win. 2604'
 TD 2613'
 5" @ 2560'
 CO to 2613' SSG frac 1500A
 220,000 cfg
 PB 2581', 15 gwph 178,000 cfg
 re-frac 70 gwph 582,000 cfg
 dec. to 5 bwph 596,000 cfg, 500A
 793,000 cfg

L

Log Tops: B. Stone Corral 2056',
 Hol. 2528', Her. 2556', Kri 2576',
 Win. 2605'
 Comp. 2,150,000 cfgpd 416#

COMPLETED

County Finney State Kansas
 Sec. 10 (Blk. Twp.) 22 (Sur. Rge.) 34W Map No.
 Operator Pet. Inc., Kansas-Nebraska & Shallow
 Well No. 1 Farm Miller Water Ref.
 Elev. 2938 Location C SE/4

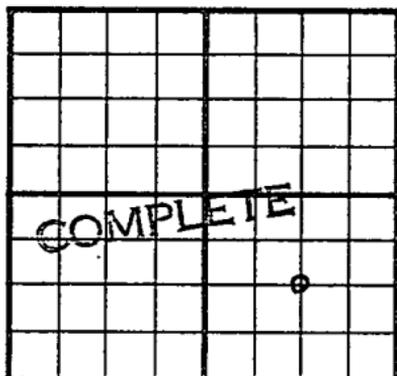

1320 Ft. From S Line SE 1/4
1320 Ft. From E Line Quarter
 Ist. Report
 Completion MAR 9 1955
 Remarks Hugoton Pool
Warvey - Contr.
 Spudding Date 1-5-55

Drlg. Data Gas well TD 2613
8" @ 285 Her. 2555 Kri. 2563
B. Kri. 2586 Win. 2604 TD 2613
5" @ 2560 CO to 2613 SSG frac 1500 A
220,000 cfg PB 2581 15 gwph 178,000
cfg re-frac 70 gwph 582,000 cfg
dec. to 5 gwph 596,000 cfg 500 A
793,000 cfg LOG TOPS:
B. Stone Corral 2056 Hol. 2528
Her. 2556 Kri. 2576 Win. 2605
Comp. 2,150,000 cfgpd 416#

FABEN GILSTRAP

County **Finney** State **Kansas**

Sec. **10** (Blk. **22**) (Sur. **34W**) (Twp.) (Rge.) Map No.

Operator **Pet. Inc., Kansas-Nebraska & Shallow**

Well No. **1** Farm **Miller** Water Ref.

Elev. **2943** Location **C SE/4**

1320 Ft. From **S** Line **SE**

1320 Ft. From **E** Line Quarter

1st. Report **JAN 1 2 1955**

Completion

Remarks

Garvey - Contr.

Spudding Date **1-5-55**

Drilg. Data **Hugoton Pool**

8" @ 285 Her. **2555** Kri. **2563**

B. Kri. 2586 Win. **2604** TD **2613**

FABEN GILSTRAP