

Albert Shuler
 31-22-11W

STANOLIND OIL & GAS CO.
 Elmer F. Allen No. 2.

SEC. 31 T. 22 R. 11W
 NEo SE
 2310' N SL 2310' E WL


Total Depth. 1787'
 Comm. 5-9-37 Comp. 5-17-37
 Shot or Treated.
 Contractor.
 Issued. 6-12-37 Rotary to 1787'

JUN 1 1937

County. Stafford

CASING:
 13" 220'

JUN 1 2 1937

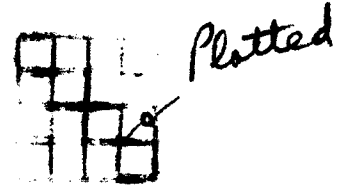

Elevation.

Production. Dry

Figures Indicate Bottom of Formations.

sand	135
red rock	220
red bed	543
anhydrite	560
shale & red rock	750
red bed & shells	830
red bed	850
shale & red bed	925
shale & shells	1009
shale & salt	1484
brkn lime	1575
lime	1677
lime & shale	1787
Total Depth.	

Abandoned hole Twisted off drill pipe