


Section 11 Township 22 Range 11W

Well No. #1 Williams

Company Westgate-Greenland

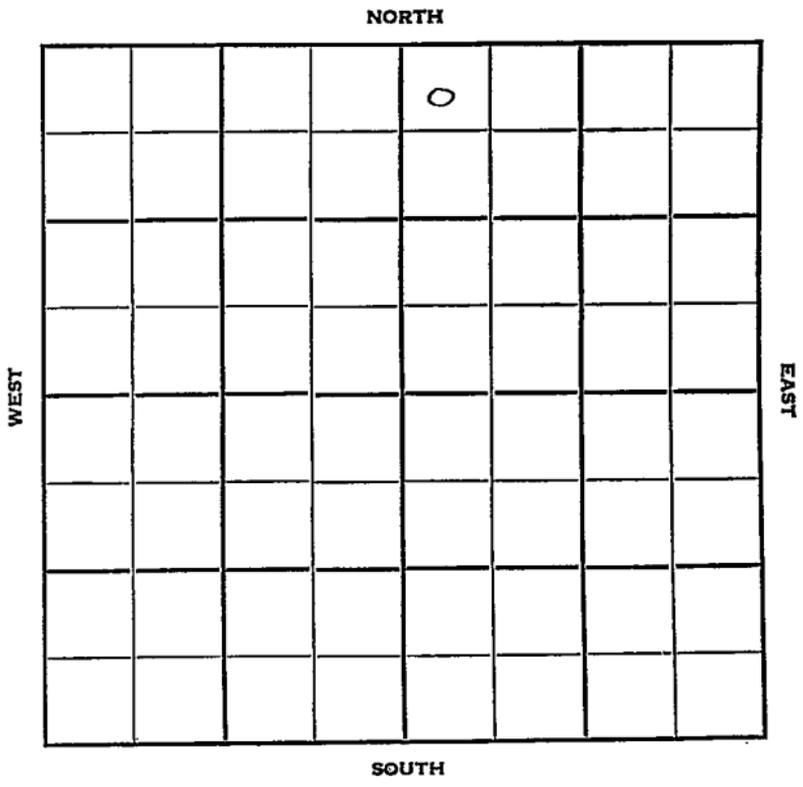

Stafford

KANSAS

Sec. 11 Twp. 22 R. 14 W

Well No. # 1 Williams Farm

Westgate-Greenland Company

Smallwood Pool Contractor


330 Ft. from N. Line

Ft. from S. Line

Ft. from E. Line

330 Ft. from W. Line

NW NW NE

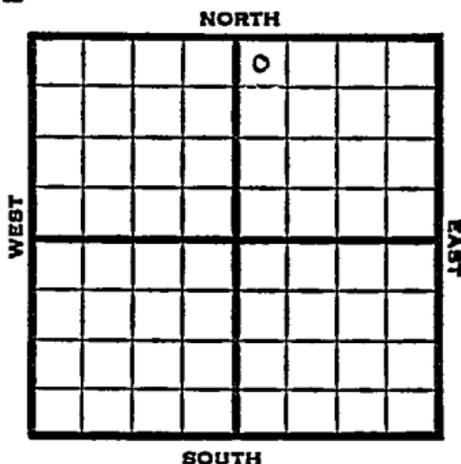

1951 Elev. 1933' REPORT

9/26 Location
11/14 Spud 9-30-51
8" @ 335'
Anhy 820 Heeb. 3286
Br. Lime 3412 Lans. 3424
DST 3541-53 open 1 hr.
Rec. 300' gas 30' O&GCM
Viola 3686 Simp. 3717
Arb. 3767
DST 3767-88 open 1 hr.
Rec. 1200' sul. wtr. TD 3788
5" @ 3601 70/ 3541-56 1000 A
S/ 55 BO 125 BW 7 hr.
D&A

ABANDONED

County **Stafford** State **Kansas**

Sec. **11** (Blk. Twp.) **22** (Sur. Rge.) **14W** Map No.

Operator **Westgate-Greenland**

Well No. **1** Farm **Williams**

Elev. Location **NW NW NE**

330 Ft. From **N** Line **NE**

330 Ft. From **W** Line **Quarter**

1st. Report **SEP 26 1951**

Completion

Remarks

Spudding Date

Drig. Data **Smallwood Pool**

Location

J. E. TYRA

