

KANSAS

Stafford

Section 11 Township 22 Range 12W

Well No. 1 Obenhaus

Company Petroleum Inc.

Max
NORTH

WEST

EAST

0							


SOUTH

Sec. 11 Twp. 22 R. 12W

Well No. #1 Obenhaus Farm
Petroleum, Inc. Company

Max Pool (Melland Drlg. Cont^{North})

 Ft. from N. Line
330' Ft. from S. Line
 Ft. from E. Line
330' Ft. from W. Line

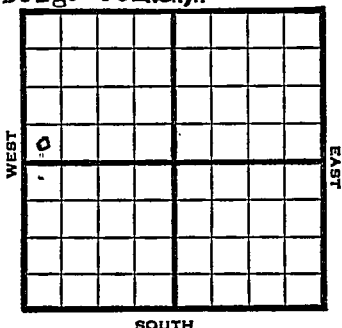

SW NW

1949 ^E lev 1846' REPORT

6/29 8" @ 210'
Anhy. 645'
Lans. 3291'
Drlg. 3445'
7/6 Viola 3556'
Arb. 3633-38'
TD 3638'
5" @ 3634'
7/12 TD 3638'
7/27 "
8/3 "
8/10 "
8/17 TD 3638'
Arb. 3633'
5" @ 3634'
Pump 25 Oil Pot
39° Gr.
Gomp

COMPLETED

Kansas

Map No. _____ Sec. 11 Twp. 22 R. 12WWell No. 1 Obenhaus

_____ Petroleum Inc. _____ Company

_____ Melland Drlg. _____ Contractor


SW NW

FIRST REPORT
SECTION PLAT

_____ Ft. from N. Line

330 Ft. from S. Line

_____ Ft. from E. Line

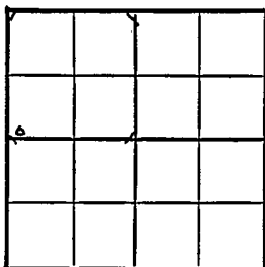330 Ft. from W. Line

Stafford County

Location _____

Rig up _____

Drilling and Remarks:

8" @ 210

Anhy 645

Lans. 3291

drlg. 3445

RECORD

Cased _____ in., _____ ft.

Sand _____

Gas _____

Oil _____

Total Depth _____

PRODUCTION

1st 24 hrs. Nat. _____

1st 24 hrs. after shot _____

Gas _____ Cu. Ft.

Dry Hole _____

Abandoned _____

Date

JUN 29 1949 19S. J. LEWIS Scout

Kansas

Map No. K46 Sec. 11 Twp. 22 R. 12W

Well No. 1 Obenhaus

Petroleum Inc. Company

COMPLETE

Contractor

SW NW

E. 1. 1846
SECTION FLAT

 Ft. from N. Line

330

 Ft. from S. Line

 Ft. from E. Line

330

 Ft. from W. Line

6			

Stafford County

Location

Rig up

Drilling and Remarks:

Cu 83633

5" 83634

Prod 25 oil Prod.

89° SW

RECORD

Cased in., ft.

Sand

Gas

Oil

Total Depth 3685

PRODUCTION

1st 24 hrs. Nat.

1st 24 hrs. after shot

Gas Cu. Ft.

Dry Hole

Abandoned

Date

AUG 17 1949 19

S. J. LEWIS Scout