


KANSAS

Section 11 Township 22 Range 12-W

Well No. #1 Bright Voight

Company Cities Service

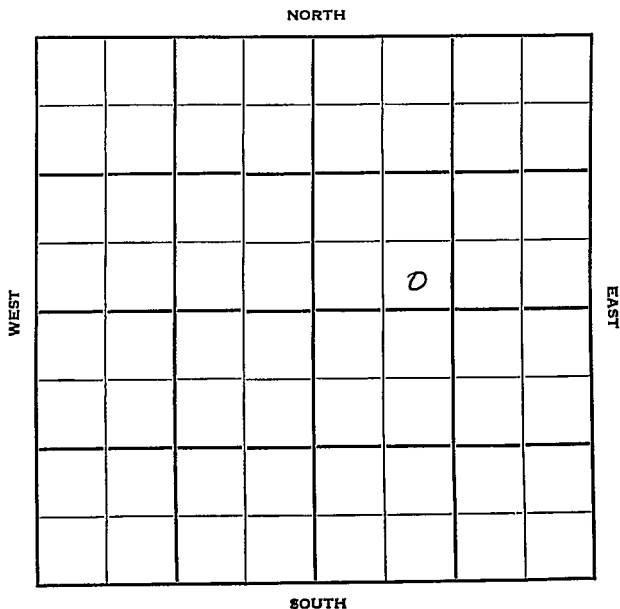

Stafford

Sec. 11 Twp. 22 R. 12W

Well No. #1 ~~Beight~~ Voight Farm

Cities Service Company

Contractor


Ft. from N. Line

330' Ft. from S. Line

Ft. from E. Line

990' Ft. from W. Line

SE SW NE

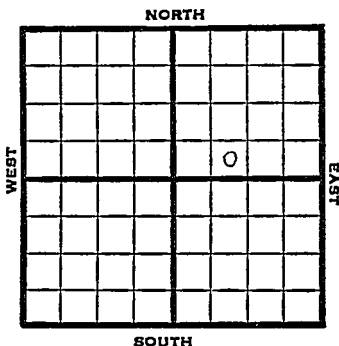

1950

Shw. 1841

REPORT

3/1

Spud 2-26-50
8" @ 240'
WOC

4/5

TD 3634'
8"@ 240'
Lans 3273'
Cong 3545'
Viola 3552'
Simp sd 3573'
Arb 3627'
5"@ 3627'
143 BOPD / 63 BWPD
Comp

COMPLETED

Kansas

Map No. _____ Sec. 11 Twp. 22 R. 12WWell No. 1 Baight

_____ Cities Service _____ Company

_____ Contractor

SE SW NE

_____ Ft. from N. Line


330 Ft. from S. Line

_____ Ft. from E. Line

990 Ft. from W. Line

Stafford County

SECTION PLAT

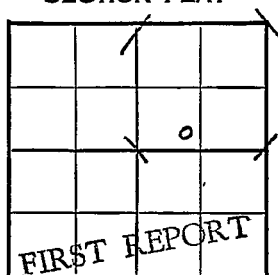

Location _____

Rig up _____

Drilling and Remarks:

Spud 2-26-50

8" @ 240

WOC

RECORD

Cased _____ in., _____ ft.

Sand _____

Gas _____

Oil _____

Total Depth _____

PRODUCTION

1st 24 hrs. Nat. _____

1st 24 hrs. after shot _____

Gas _____ Cu. Ft.

Dry Hole _____

Abandoned _____

Date

MAR 1 1950 19 J. E. TYRA Scout

Kansas

Map No. _____ Sec. 11 Twp. 22 R. 12WWell No. 1 Voight

_____ Cities Service _____ Company

_____ **CORRECTION** _____ Contractor


SE SW NE

E. 1841**SECTION PLAT**

_____ Ft. from N. Line

330 Ft. from S. Line

_____ Ft. from E. Line

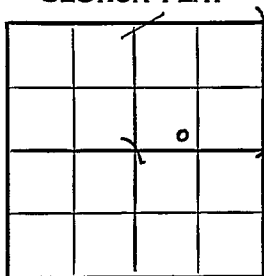990 Ft. from W. Line_____ **Stafford County** _____

Location _____

Rig up _____

Drilling and Remarks:

Reported
#1 Baight**RECORD**

Cased _____ in., _____ ft.

Sand _____

Gas _____

Oil _____

Total Depth _____

PRODUCTION

1st 24 hrs. Nat. _____

1st 24 hrs. after shot _____

Gas _____ Cu. Ft.

Dry Hole _____

Abandoned _____

Date

J. E. TYRAAPR 5 1950 19 _____ Scout

Map No. _____ Sec. 11 Twp. 22 R. 12WWell No. 1 Voight

Cities Service

Company

Contractor

SE SW NE

E1 1841
SECTION PLAT

COMPLETE			

_____ Ft. from N. Line

330 Ft. from S. Line

_____ Ft. from E. Line

990 Ft. from W. Line

Stafford County

Location _____

Rig up _____

Drilling and Remarks:

8" @ 240
 Sand 3273
 Cong 3545
 Viola 3552
 Simp Sh 3573
 Arb 3627

RECORD

Cased _____ in., _____ ft.

Sand _____

Gas _____

Oil _____

Total Depth 3634

PRODUCTION

1st 24 hrs. Nat. _____

1st 24 hrs. after shot _____

Gas _____ Cu. Ft.

Dry Hole _____

Abandoned _____

5" @ 3627

Date 143 BOPD + 63 BWPD

ADD 5

1950 19

J. E. TYRA

Scout