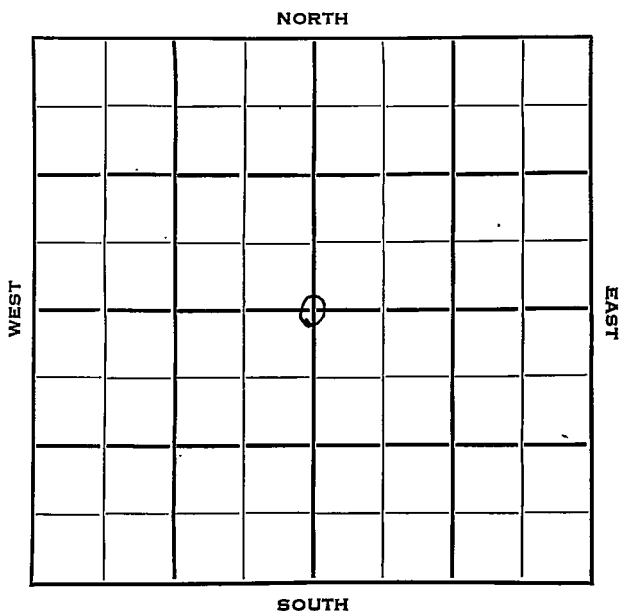


Section 11 Township 22 Range 33 WWell No. # 1 E. Kisner "B" UnitCompany Texas Company

Finney KANSAS

SEC.	TWP.	R.
11	22	33W ✓

WELL NO.

1 E. Kisner "B" Unit

FARM

COMPANY

Texas Company

CONTRACTOR

Stickle Drlg.


Hugoton Pool

2640 Ft. from N. Line

Ft. from S. Line

Ft. from E. Line

2640 Ft. from W. Line

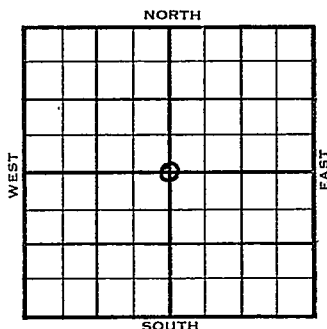

C Sec.

	ELEVATION	REPORT
1954	2900'	
3/31	Spud 3-27-54	
	10" @ 504', WOC	
4/7	TD 2732'	
	7" @ 2731'	
5/5	Spud 3-27-54	
	Gas Well	
	TD 2732'	
	10" @ 504'	
	TD 2732'	
	7" @ 2731'	
	CO to 2696'	
	26/2662-75, 500A	
	88/2630-52	
	frac., 7 mcfg	
	Hol 2594', Her. 2627', Kri 2644', Win 2661'	
	Comp. 18,900,000 gas	


COMPLETED

County Finney State Kansas
 Sec. 11 (Blk.) 22 (Sur.) 33W Map No.
 Operator Texas Company
 Well No. 1 Farm E. Kisner "B" Unit
 Elev. Location C Sec.



2640 Ft. From N Line Sec.
2640 Ft. From W Line Quarter
 Ist. Report MAR 31 1954
 Completion
 Remarks
Stickle Drlg. - Contr.
 Spudding Date 3-27-54

Drlg. Data Hugoton Pool
10" @ 504 WOC

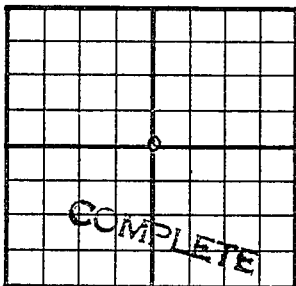County Finney State KansasSec. 11 (Blk.
Twp.) 22 (Sur.
Rge.) 33W Map No.Operator Texas CompanyWell No. 1 Farm E. Kisner "B" UnitElev. 2900 Location C Sec.2640 Ft. From N Line Sec.2640 Ft. From W Line Quarter

1st. Report

MAY 5 1954

Completion

Remarks Hugoton PoolStickle Drlg. - Contr.Spudding Date 3-27-54Drlg. Data Gas well TD 273210" @ 504 TD 2732 7" @ 2731 CO to 269626/ 2662-75 500 A 88/ 2630-52frac 7 mcfg Hol. 2594 Her. 2627Kri. 2644 Win. 2661Comp. 18,900,000 gas

J. G. McGEHEE