
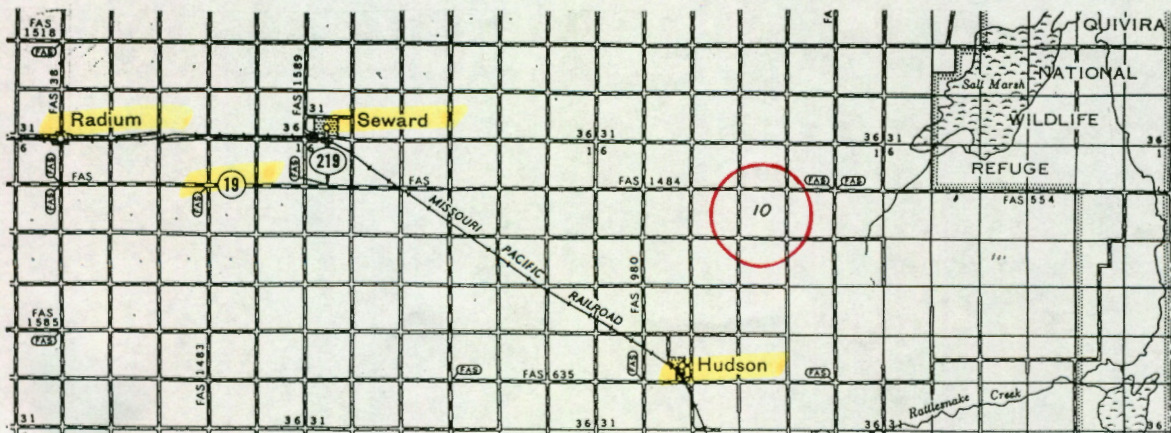


RUPE OIL COMPANY, INC.
 AHNERT LEASE
 NE. 1/4, SECTION 10, T22S, R12W
 STAFFORD COUNTY, KANSAS

6 MILES TO
 HWY. 281

* Ingress and egress to location as shown on this plat is per usage only and may not be legally opened for public use. Contact landowner, tenant and county road department for access.

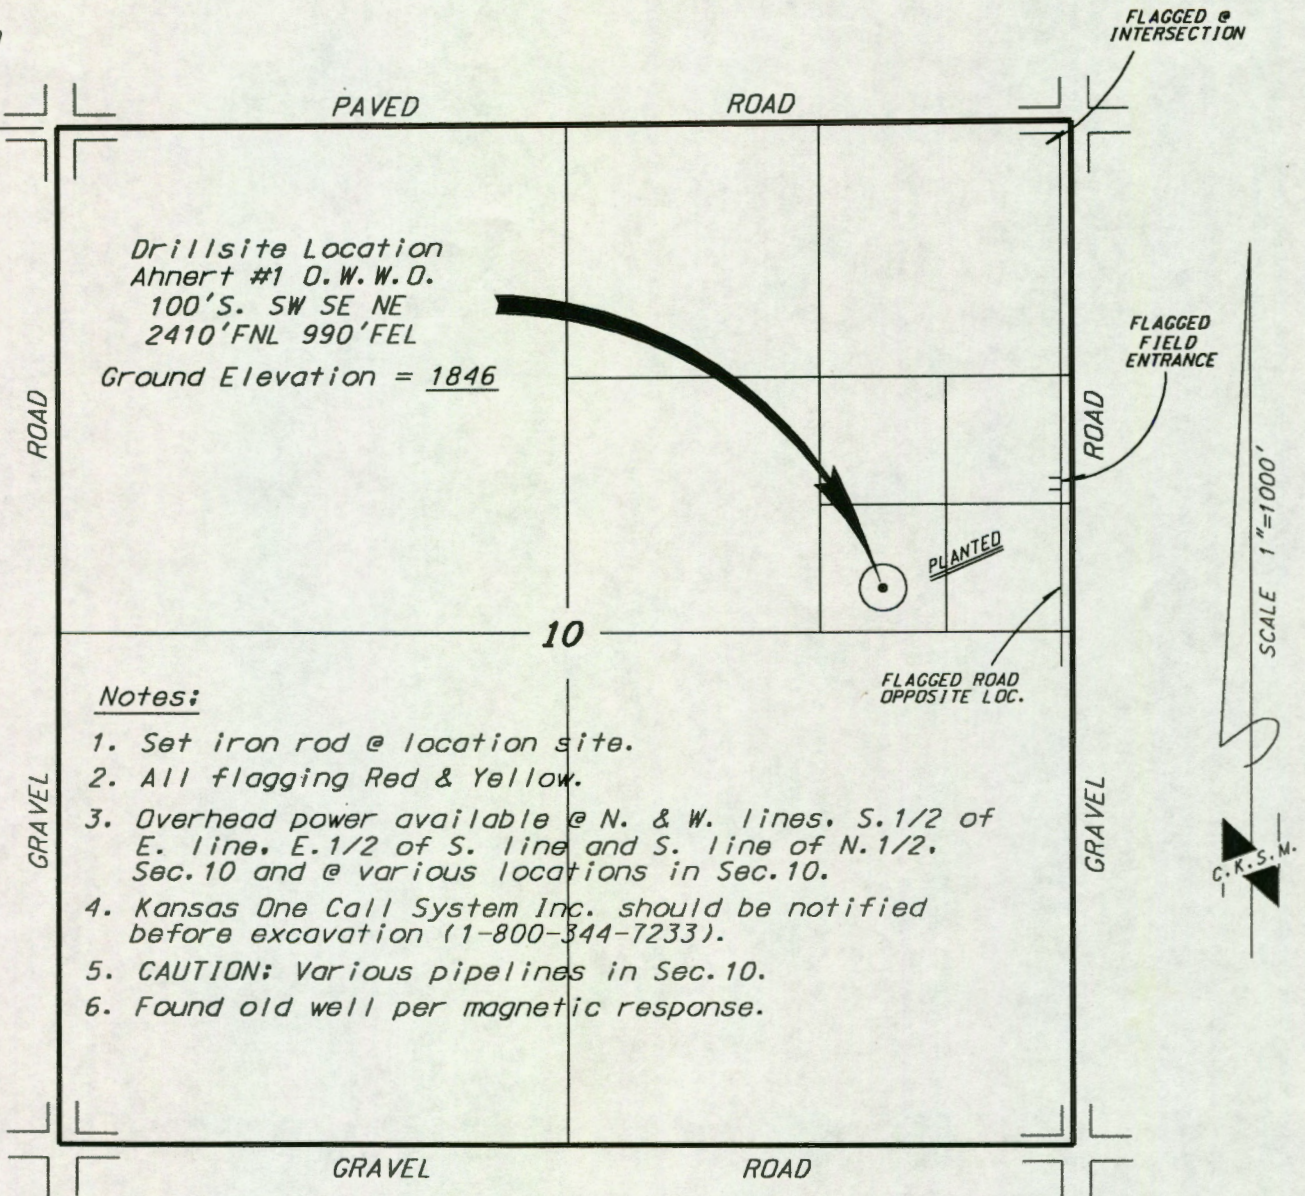


* Controlling data is based upon the best maps and photographs available to us and upon a regular section of land containing 640 acres.

* Approximate section lines were determined using the normal standard of care of allfield surveyors practicing in the state of Kansas. The section corners, which establish the precise section lines, were not necessarily located, and the exact location of the drillsite location in the section is not guaranteed.

* Elevations derived from National Geodetic Vertical Datum.

Date August 13, 1998

CENTRAL KANSAS SURVEYING & MAPPING, INC. (316) 792-5754

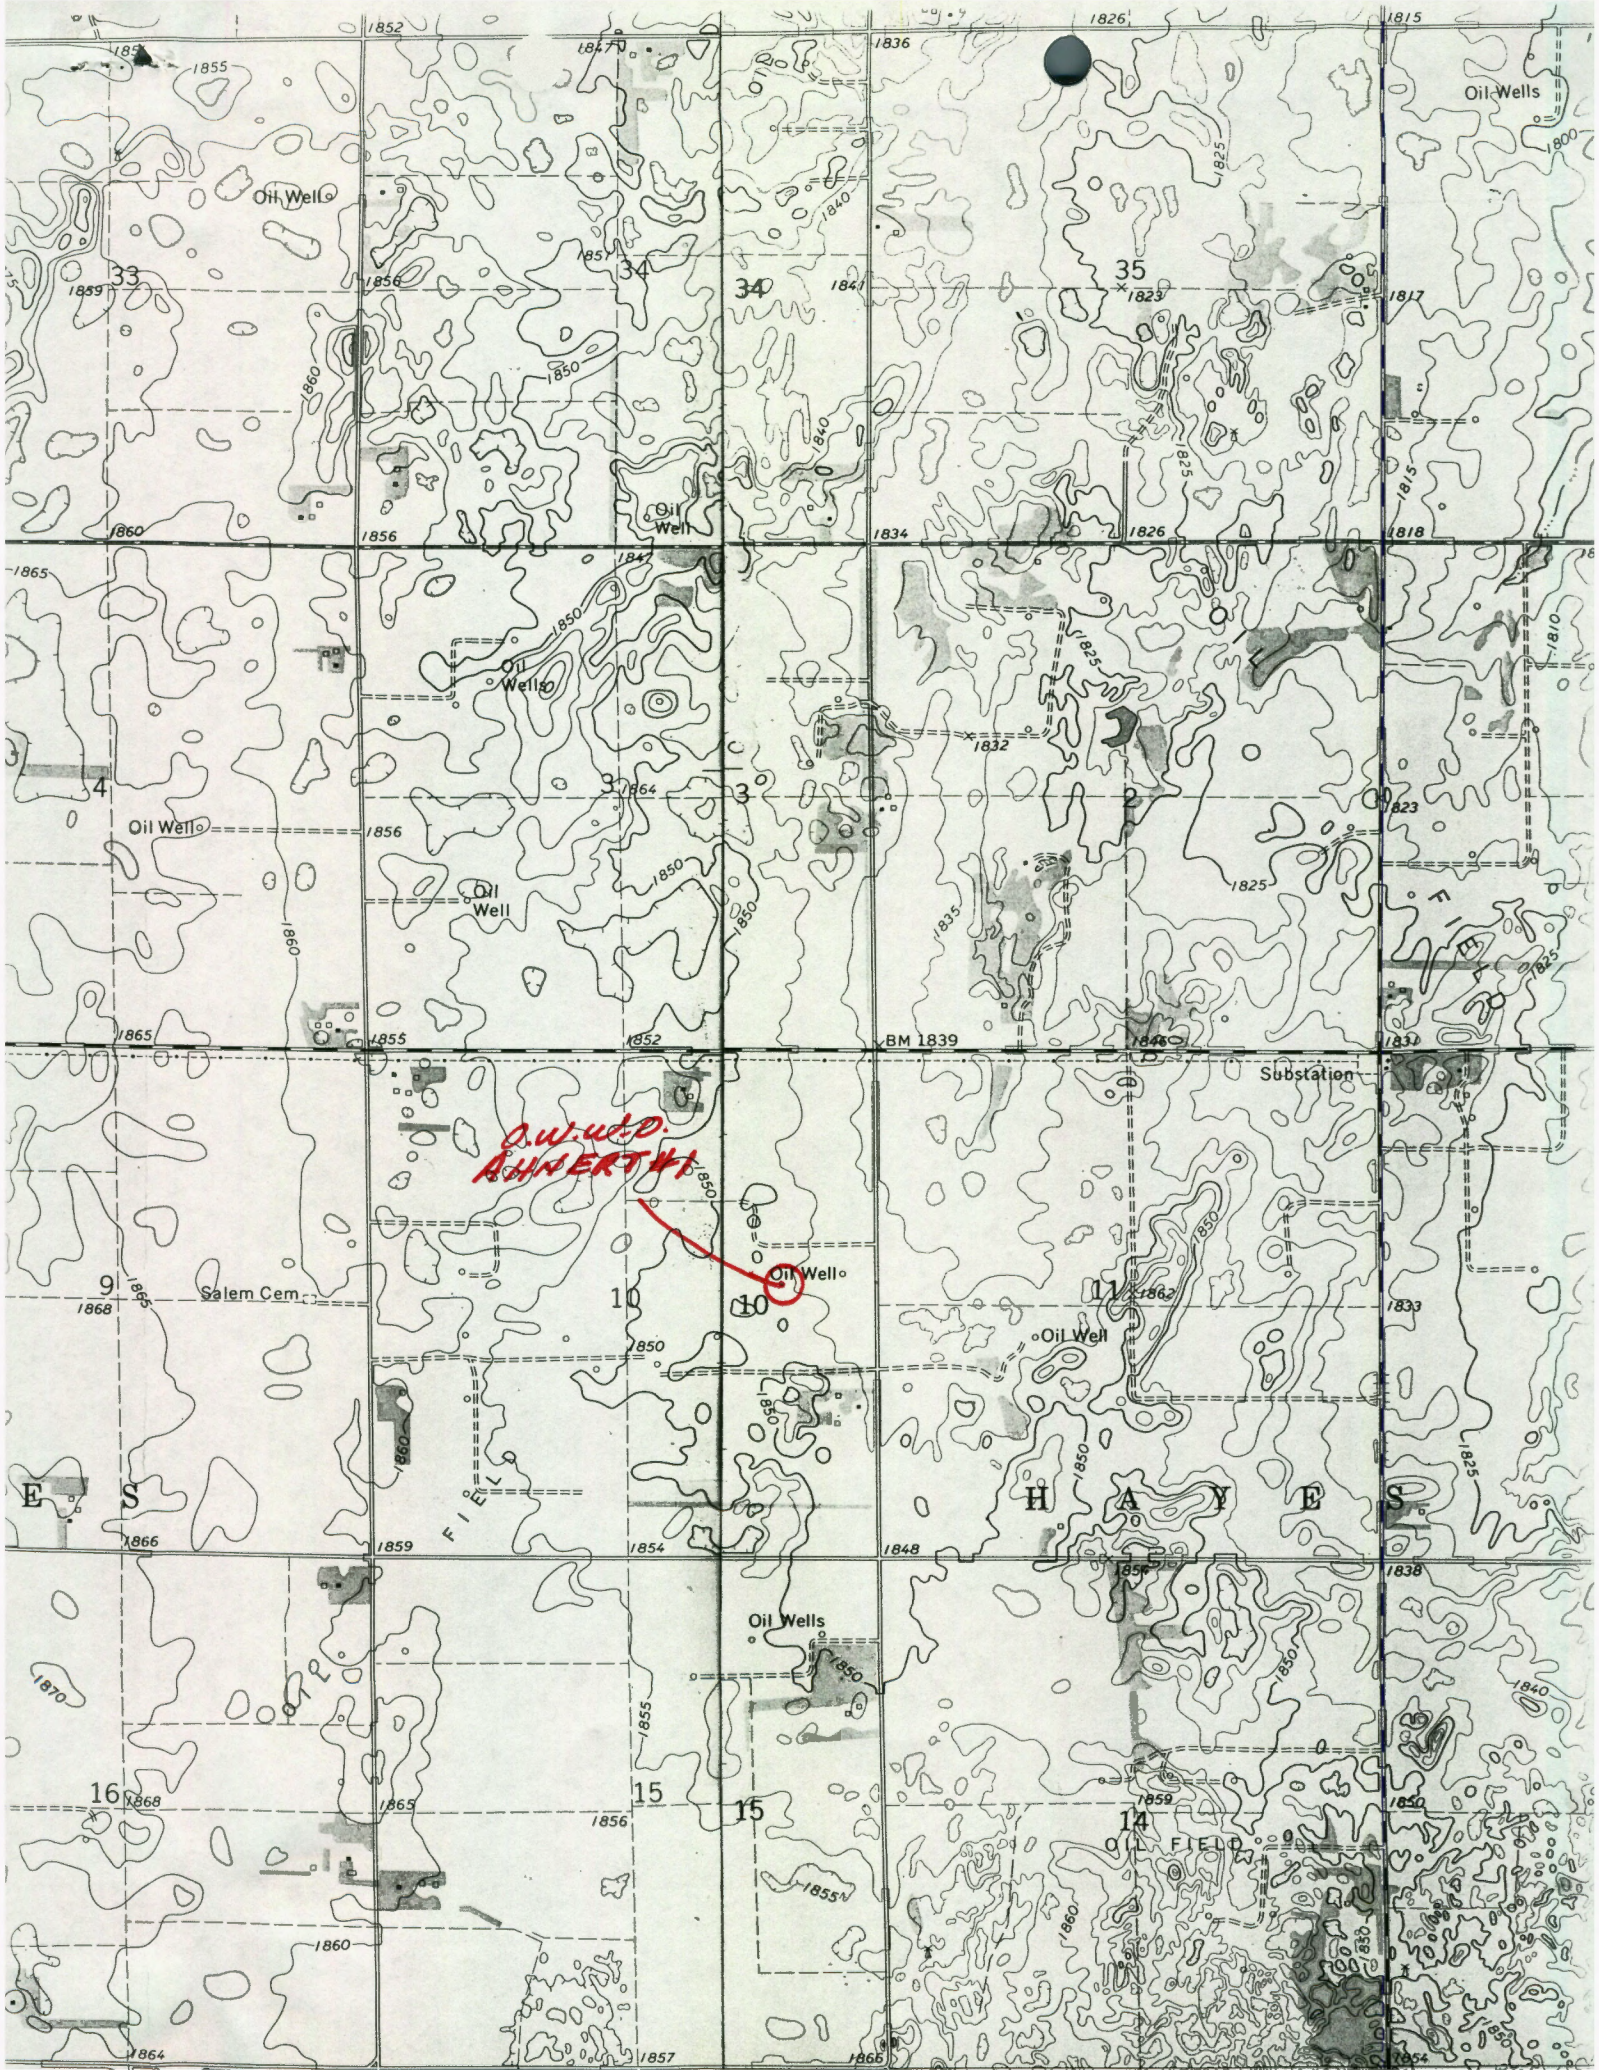

Township 22 S Range 12 W County Stafford State Ks

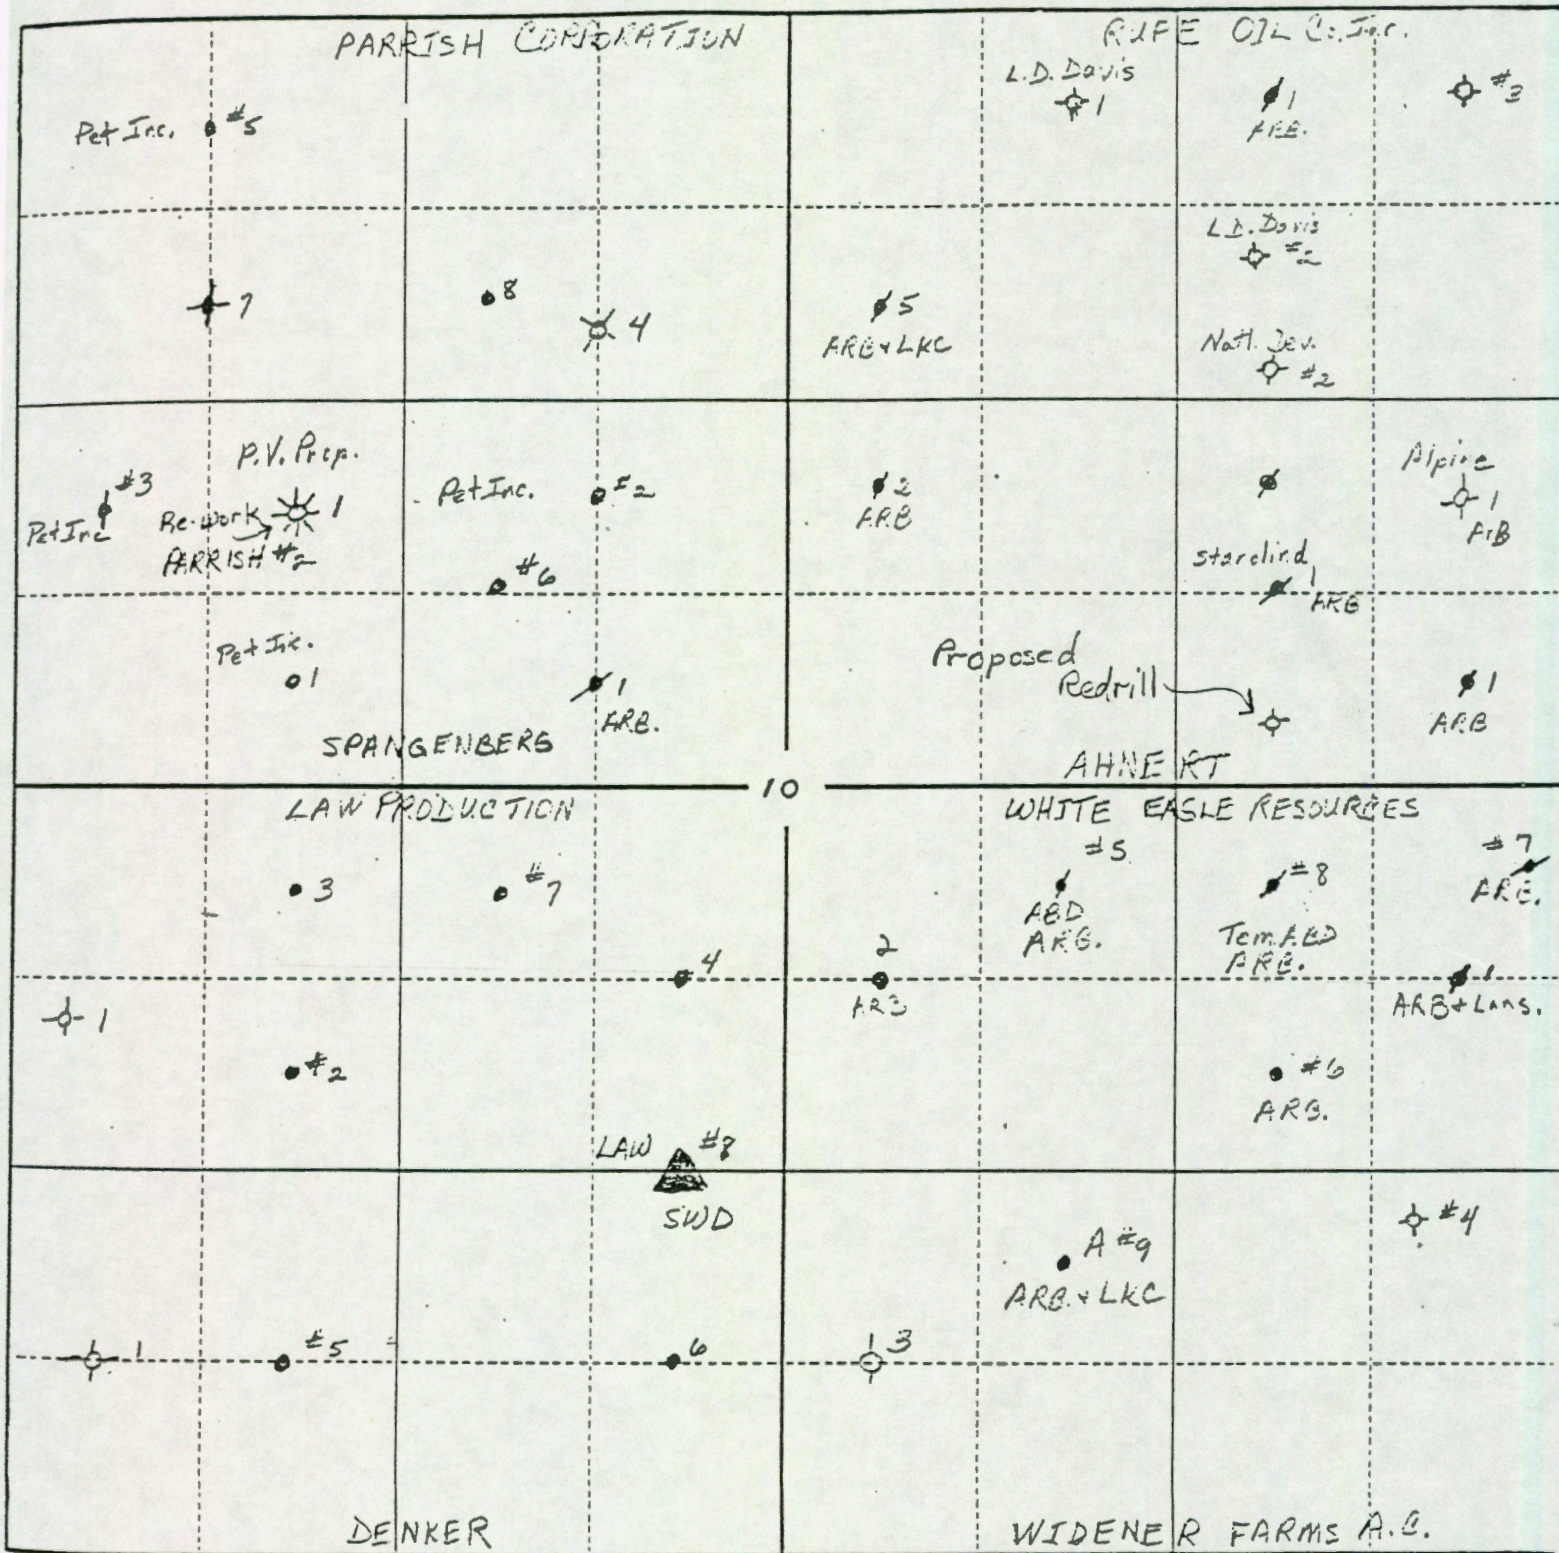


EXHIBIT "A"

Township 22 S Range 12 W County Stafford State Ks