
FORM 51 5M 11-44 PETROL

KANSAS Stafford

Section 12 Township 22 Range 13W

Well No. #1 Drach

Company Hershfield et al

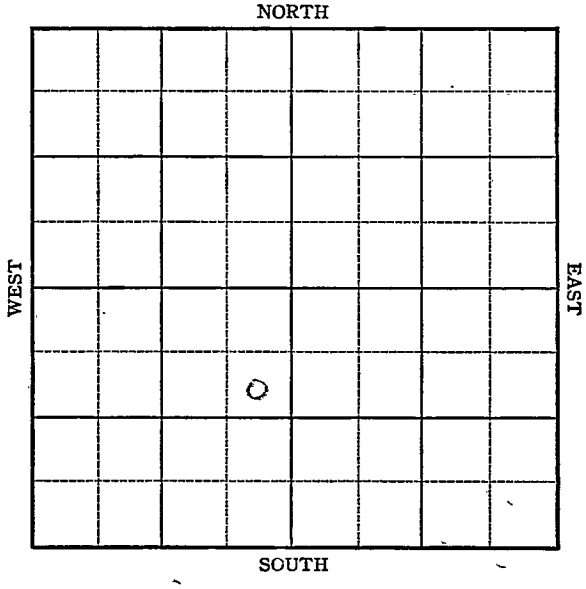

FORM 252-A
5M 9-44 PETROL

KANSAS

Stafford

Sec. 12 Twp. 22 R. 13W

Well No. #1 Drach Farm

Hershfield et al Company

Drach


990 Ft. from N. Line

Ft. from S. Line

330 Ft. from E. Line

Ft. from W. Line

SE NE SW Elev. 1882

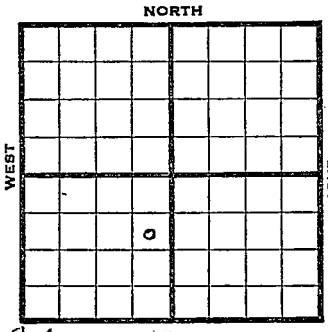


| 1945 | REPORT |
|---|---|
| 3/14 | Location |
| 3/23 | Derrick |
| 3/29 | " |
| 4/5 | RUR |
| 4/12 | 10" @ 240<br>Drlg. 1780' |
| 4/20 | Lans 3232<br>Drlg. 3350 |
| 4/27 | Lans 3351 corrected<br>Cong 3603<br>Viola 3611<br>Simp 3641<br>Arb 3692-95<br>TD 3695<br>5" @ 3692' RUST |
| 5/3 | " " " " " " |
| 5/10 | " " " " " " |
| 5/17 | 2000' oil 12 hrs. |
| 5/24 | " " " " |
| 5/31 | " " " " |
| 6/8 | " " " " |
| 6/14 | " " " " |
| 6/21 | " " " " |
| 6/28 | " " " " |
| 7/3 | 2000 oil 12 hrs. |
| 7/11 | 300 acid.<br>Pump 100 oil 12 hrs. plus 3% wtr. |
| 7/19 | " " " " " " " " |
| 7/26 | " " " " " " " " |

OVER

1945

8/1 300 acid
Pump 100 oil 12 hrs. plug 3% wtr.
8/8 " " " " "
8/15 " " " " "
8/22 " " " " "
8/29 " " " " "
9/5 " " " " "
9/12 Arb. 3692
5" @ 3692
300 acid.
TD 3695'
Pump 100 Pot.
Grav. 37.0

COMPLETED

FORM 26 200 BKS. 2-44 PETROL

Pool Name Drach

Map No 27 Sec. 12 Twp. 22 R. 13W


Well No. 1 Drach

Hershfield et al Company

FIRST REPORT Contractor

SE NE SW

SECTION PLAT

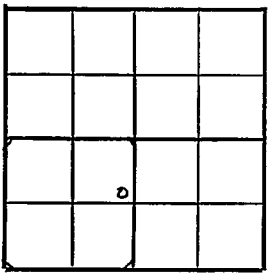

990 Ft. from N. Line

Ft. from S. Line

330 Ft. from E. Line

Ft. from W. Line

Stafford

Location X

Rig up

Drilling and Remarks:

RECORD

Cased in., ft.

Sand

Gas

Oil

Total Depth

PRODUCTION

1st 24 hrs. Nat.

1st 24 hrs. after shot

Gas Cu. Ft.

Dry Hole

Abandoned

Date

MAR 14 1945 19

S. J. LEWIS Scout

FORM 26 200 BKS 1-44 PETROL

KANSAS Kan... Pool Name Drach

Map No. 8 2 Sec. 12 Twp. 22 R. 13W

Well No. 1 Drach


Hershfield etal. Company

COMPLETED Contractor

SE NE SW

E.L. 1886

SECTION PLAT

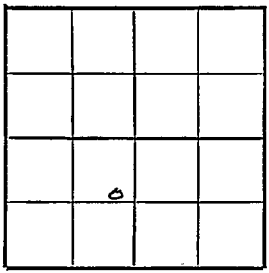

990 Ft. from N. Line

Ft. from S. Line

330 Ft. from E. Line

Ft. from W. Line

Stafford County

Location

Rig up

Drilling and Remarks:

Cr X3692

5' C03692

800 cal

Pump 100 BF

37 0 Gr

RECORD

Cased ... in., ... ft.

Sand

Gas

Oil

Total Depth 3685

PRODUCTION

1st 24 hrs. Nat.

1st 24 hrs. after shot

Gas Cu. Ft.

Dry Hole

Abandoned

Date

SEP 12 1945 19 S. J. LEWIS Scout