


Section 12 Township 22 Range 13 W

Well No. # 1 Drach "B"

Company Lindsley Drlg. & Vince Bryne

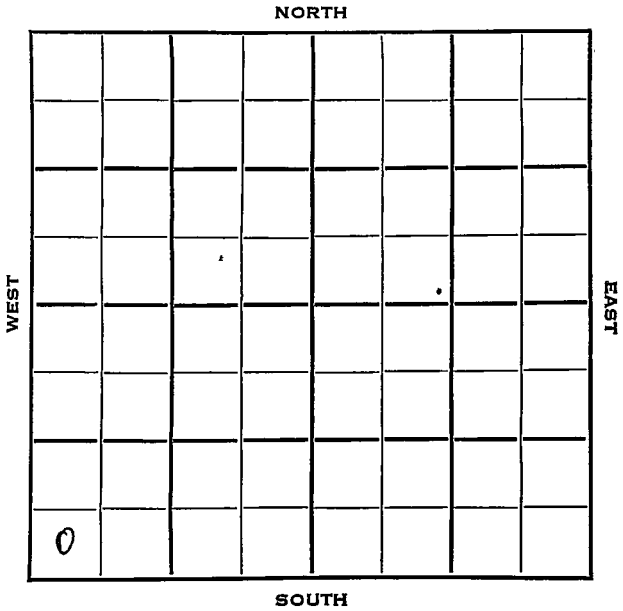

# Stafford

SEC.  12	TWP.  22	R.  KANSAS 13W ✓
----------------	----------------	---------------------------

WELL NO. #1 Drach "B" FARM

COMPANY  
**Lindsley Drlg. & Vince Byrne**


CONTRACTOR  
**Lindsley**

\_\_\_\_\_ Ft. from N. Line

**330** \_\_\_\_\_ Ft. from S. Line

\_\_\_\_\_ Ft. from E. Line

**330** \_\_\_\_\_ Ft. from W. Line

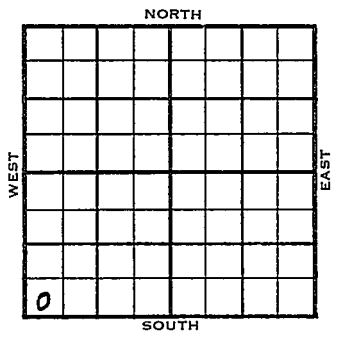

SW SW SW  
Edminston - DHM

	ELEVATION	REPORT
1953	1895'	

12/22

1954  
1/6

Spud 12-18-53  
8" @ 256'  
Drlg 1900'

Spud 12-18-53  
D & A  
TD 3810'  
8" @ 256'  
Heeb 3240', Br. Lime 3375', Lans 3392'  
Cong 3643', Viola 3698', Simp 3756'  
Arb 3791'  
DST 3793'-3810' opn 1 hr, rec 15' Mud  
12#  
TD 3810'  
D & A

**ABANDONED**



