


Stafford

KANSAS

Section 12 Township 22 Range 13-W

Well No. 1 - Drach

Company Fred Rust et al .

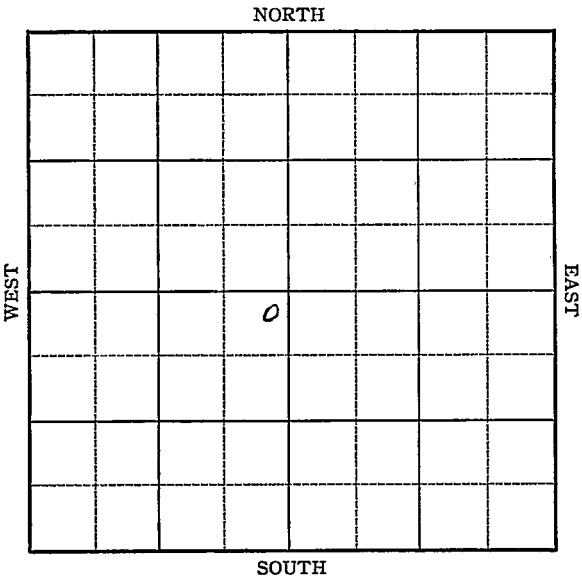

1937

11/5 Correction: 3698=3700'.
Sil. & 6" @ 3695' (Corrected)
T.D. 3705'. 1250' oil 18 hrs.
Swab 20 bbls. oil 1 hour.
3100' fill-up over-nite.
Will acidize.

11/12 T.D. 3705'. Pump 589 bbls. 22
hrs. Nat. 1000 acid.
Pumped 102 bbls. 2 hrs.

11/20--Pumped 189 bbls. in 4 hours
" 157 " " 4 "
24 hour potential 945 bbls. (Tel)

11/23 6" @ 3693'.
Sil. 3695'.
T.D. 3705'.
5000 acid.
Pump 189 bbls. 4 hrs. & 158
bbls. 4 hours.
Potential 945 bbls.
Gravity 35.2

COMPLETED

Stafford KANSAS

Map No. 82 Sec. 12 Twp. 22 R. 13WWell No. 1- DrachFred Rust et al

Company

Contractor

FIRST REPORT

NE SW

330

Ft. from N. Line

Ft. from S. Line

330

Ft. from E. Line

Ft. from W. Line

SECTION PLAT

	0		

Location _____

Rig up _____

Drilling and Remarks:

Mov. In Matl.(Stano. Farm out)

RECORD

Cased _____ in., _____ ft.

Sand _____

Gas _____

Oil _____

Total Depth _____

PRODUCTION

1st 24 hrs. Nat. _____

1st 24 hrs. after shot _____

Gas _____ Cu. Ft.

Dry Hole _____

Abandoned _____

Date

SEP 29 1937

19

H. D. Hatfield

Scout

Stafford KANSAS

Map No. 82 Sec. 12 Twp. 22 R. 13WWell No. 1 DrachFred Rust et al

Company

Contractor

COMPLETED

NE SW

330 Ft. from N. Line Ft. from S. Line330 Ft. from E. Line Ft. from W. Line

SECTION PLAT

	0		

Location Rig up

Drilling and Remarks:

5000 acidP-189/4 158/4POT - 945grav 35.2

RECORD

Cased 6 in., 3693 ft.~~Sand~~ Si 1 3695Gas Oil Total Depth 3705

PRODUCTION

1st 24 hrs. Nat. 1st 24 hrs. after shot Gas Cu. Ft.Dry Hole Abandoned

Date

NOV 23 1937

19

H. D. Hatfield

Scout